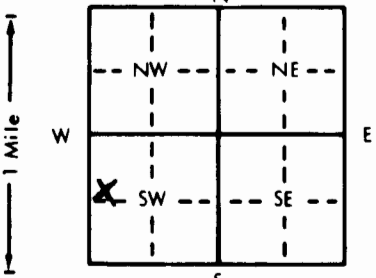


1 LOCATION OF WATER WELL: Fraction SW 1/4 NW 1/4 SW 1/4 Section Number 5 Township Number T 11 S Range Number R 22 E W  
 County: Leavenworth

Distance and direction from nearest town or city street address of well if located within city?  
118860 182nd St, Tonganoxie, KS

2 WATER WELL OWNER: David Keller  
 RR#, St. Address, Box #: P.O. Box 640 Board of Agriculture, Division of Water Resources  
 City, State, ZIP Code: Tonganoxie KS 66086 Application Number:

3 LOCATE WELL'S LOCATION WITH AN "X" IN SECTION BOX:  


4 DEPTH OF COMPLETED WELL: 100 ft. ELEVATION:  
 Depth(s) Groundwater Encountered 1. 35-75 ft. 2. ft. 3. ft.  
 WELL'S STATIC WATER LEVEL: 17 ft. below land surface measured on mo/day/yr 4-9-96  
 Pump test data: Well water was ft. after hours pumping gpm  
 Est. Yield 16 gpm Well water was ft. after hours pumping gpm  
 Bore Hole Diameter: 8 3/4 in. to 20 ft., and 7 7/8 in. to 100 ft.  
 WELL WATER TO BE USED AS:  
 Domestic 3 Feedlot 6 Oil field water supply 9 Dewatering 12 Other (Specify below)  
 Irrigation 4 Industrial 7 Lawn and garden only 10 Monitoring well  
 Was a chemical/bacteriological sample submitted to Department? Yes No ; If yes, mo/day/yr sample was submitted  
 Water Well Disinfected? Yes  No

5 TYPE OF BLANK CASING USED:  
 1 Steel 3 RMP (SR) 5 Wrought iron 8 Concrete tile CASING JOINTS: Glued  Clamped  
 PVC 4 ABS 6 Asbestos-Cement 9 Other (specify below) Welded  
 7 Fiberglass Threaded  
 Blank casing diameter: 5 in. to 90 ft., Dia. in. to ft., Dia. in. to ft.  
 Casing height above land surface: 36 in., weight 200 PSI lbs./ft. Wall thickness or gauge No.  
 TYPE OF SCREEN OR PERFORATION MATERIAL:  
 PVC 10 Asbestos-cement  
 1 Steel 3 Stainless steel 5 Fiberglass 8 RMP (SR) 11 Other (specify)  
 2 Brass 4 Galvanized steel 6 Concrete tile 9 ABS 12 None used (open hole)  
 SCREEN OR PERFORATION OPENINGS ARE:  
 1 Continuous slot  Mill slot 5 Gauzed wrapped 8 Saw cut 11 None (open hole)  
 2 Louvered shutter 4 Key punched 6 Wire wrapped 9 Drilled holes  
 7 Torch cut 10 Other (specify)  
 SCREEN-PERFORATED INTERVALS: From 90 ft. to 100 ft., From ft. to ft.  
 From ft. to ft., From ft. to ft.  
 GRAVEL PACK INTERVALS: From 20 ft. to 100 ft., From ft. to ft.  
 From ft. to ft., From ft. to ft.

6 GROUT MATERIAL: 1 Neat cement 2 Cement grout  Bentonite 4 Other  
 Grout Intervals: From 20 ft. to 0 ft., From ft. to ft., From ft. to ft.  
 What is the nearest source of possible contamination: NONE At time of Drilling  
 1 Septic tank 4 Lateral lines 7 Pit privy 10 Livestock pens 14 Abandoned water well  
 2 Sewer lines 5 Cess pool 8 Sewage lagoon 11 Fuel storage 15 Oil well/Gas well  
 3 Watertight sewer lines 6 Seepage pit 9 Feedyard 12 Fertilizer storage 16 Other (specify below)  
 13 Insecticide storage  
 Direction from well? How many feet?

FROM	TO	LITHOLOGIC LOG	FROM	TO	PLUGGING INTERVALS
0	12	Soil + Clay			
12	16	Shale			
16	18	Coal			
18	35	Shale			
35	75	SAND - grey, water			
75	86	Limestone			
86	90	Shale			
90	96	Limestone			
96	100	Shale			

7 CONTRACTOR'S OR LANDOWNER'S CERTIFICATION: This water well was  constructed,  reconstructed, or  plugged under my jurisdiction and was completed on (mo/day/year) 4-9-96 and this record is true to the best of my knowledge and belief. Kansas  
 Water Well Contractor's License No. 561 This Water Well Record was completed on (mo/day/yr) 4-9-96  
 under the business name of EVANS ENERGY DEVELOPMENT, INC by (signature) [Signature]