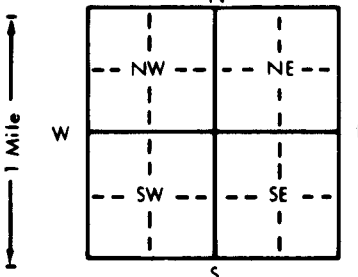


1 LOCATION OF WATER WELL: Fraction NE 1/4 NW 1/4 NW 1/4 Section Number 3 Township Number T 11 S Range Number R 22E EW  
 County: LEAVENWORTH  
 Distance and direction from nearest town or city street address of well if located within city?  
 .9 west of Basehor Well @ 16383 Paralell, Basehor, KS

2 WATER WELL OWNER: Scott Hoffman  
 RR#, St. Address, Box # : 16383 Paralell Board of Agriculture, Division of Water Resources  
 City, State, ZIP Code : Basehor, KS 66007 Application Number:

3 LOCATE WELL'S LOCATION WITH AN "X" IN SECTION BOX:  4 DEPTH OF COMPLETED WELL... 121' ft. ELEVATION:  
 Depth(s) Groundwater Encountered 1. .... ft. 2. .... ft. 3. .... ft.  
 WELL'S STATIC WATER LEVEL ... 40' ft. below land surface measured on mo/day/yr ... 09/30/99  
 Pump test data: Well water was .... ft. after .... hours pumping .... gpm  
 Est. Yield ... 1 1/2 gpm: Well water was .... ft. after .... hours pumping .... gpm  
 Bore Hole Diameter. 8 3/4 .in. to .... ft., and .... in. to .... ft.  
 WELL WATER TO BE USED AS: 5 Public water supply 8 Air conditioning 11 Injection well  
 1 Domestic 3 Feedlot 6 Oil field water supply 9 Dewatering 12 Other (Specify below)  
 2 Irrigation 4 Industrial 7 Lawn and garden only 10 Monitoring well  
 Was a chemical/bacteriological sample submitted to Department? Yes.....No... X.....; If yes, mo/day/yr sample was sub-  
 mitted Water Well Disinfected? Yes X No

5 TYPE OF BLANK CASING USED: 5 Wrought iron 8 Concrete tile CASING JOINTS: Glued X Clamped  
 1 Steel 3 RMP (SR) 6 Asbestos-Cement 9 Other (specify below) Welded  
 2 PVC 4 ABS 7 Fiberglass Threaded  
 Blank casing diameter . 5" . in. to . 0-40 . ft., Dia . 5" . in. to . 60-120 . ft., Dia . 5" . in. to . ft.  
 Casing height above land surface . 24 . in., weight . 2.82 . lbs./ft. Wall thickness or gauge No. . 258  
 TYPE OF SCREEN OR PERFORATION MATERIAL: 7 PVC 10 Asbestos-cement  
 1 Steel 3 Stainless steel 5 Fiberglass 8 RMP (SR) 11 Other (specify)  
 2 Brass 4 Galvanized steel 6 Concrete tile 9 ABS 12 None used (open hole)  
 SCREEN OR PERFORATION OPENINGS ARE: 5 Gauzed wrapped 8 Saw cut 11 None (open hole)  
 1 Continuous slot 3 Mill slot 6 Wire wrapped 9 Drilled holes  
 2 Louvered shutter 4 Key punched 7 Torch cut 10 Other (specify)  
 SCREEN-PERFORATED INTERVALS: From . 40 . ft. to . 60 . ft., From . ft. to . ft.  
 From . 120 . ft. to . 121 . ft., From . ft. to . ft.  
 GRAVEL PACK INTERVALS: From . 24 . ft. to . 121 . ft., From . ft. to . ft.  
 From . ft. to . ft., From . ft. to . ft.

6 GROUT MATERIAL: 1 Neat cement 2 Cement grout 3 Bentonite 4 Other  
 Grout intervals: From . 4 . ft. to . 24 . ft., From . ft. to . ft., From . ft. to . ft.  
 What is the nearest source of possible contamination:  
 1 Septic tank 4 Lateral lines 7 Pit privy 10 Livestock pens 14 Abandoned water well  
 2 Sewer lines 5 Cess pool 8 Sewage lagoon 11 Fuel storage 15 Oil well/Gas well  
 3 Watertight sewer lines 6 Seepage pit 9 Feedyard 12 Fertilizer storage 16 Other (specify below)  
 13 Insecticide storage  
 Direction from well? SOUTH How many feet? 200'

FROM	TO	LITHOLOGIC LOG	FROM	TO	PLUGGING INTERVALS
0	1	Top Soil	67	69	IS-Grey
1	14	Clay-Br-Grey Streaks	69	74	IS-White
14	15	Coal	74	82	IS-Grey
15	18	Clay-Tan	82	85	Shale-Grey-Dark
18	19	Shale-Tan	85	86	Shale-Black
19	33	Shale-Grey	86	88	IS-Grey
33	34	Sandstone-Brown	88	102	Shale-Grey
34	41	Shale-Grey-Sandy	102	103	IS-Grey
41	52	SS-Grey-Soft	103	109	Shale-Grey
52	54	SS-Grey-Hard-Limey	109	113	IS-Grey
54	56	IS-Grey-Sandy	113	115	Shale-Grey-Limey
56	58	Shale-Grey	115	121	Limestone-Grey-Hard
58	60	Limestone-Brown			
60	62	IS-Grey			
62	67	Shale-Grey			

7 CONTRACTOR'S OR LANDOWNER'S CERTIFICATION: This water well was (1) constructed, (2) reconstructed, or (3) plugged under my jurisdiction and was completed on (mo/day/year) ... 09/30/99 ... and this record is true to the best of my knowledge and belief. Kansas Water Well Contractor's License No. ... 182 ... This Water Well Record was completed on (mo/day/yr) 10-29-99 under the business name of STRADER DRILLING CO., INC. by signature Dale Strader

OFFICE USE ONLY  
T  
R  
EW  
SEC  
1/4  
1/4  
1/4