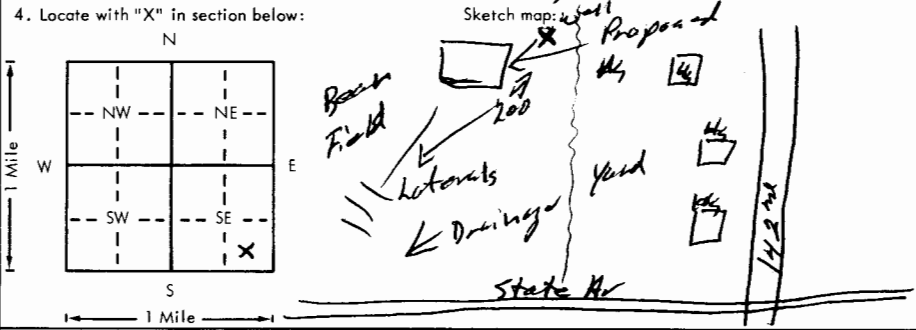


118

USE TYPEWRITER OR BALL POINT PEN-PRESS FIRMLY, PRINT CLEARLY.

WATER WELL RECORD
KSA 82a-1201-1215

Kansas Department of Health and Environment-Division of Environment
(Water well Contractors)
Topeka, Kansas 66620

1. Location of well: County <u>Leavenworth</u> Fraction <u>SE 1/4 SE 1/4 SE 1/4</u> Section number <u>1</u> Township number <u>T 11 S R 22 EW</u> Range number	
2. Distance and direction from nearest town or city: Street address of well location if in city: <u>Baschior City Limits</u> 3. Owner of well: <u>GARY Stutz</u> R.R. or street: <u>RR. P.O. Box 117</u> City, state, zip code: <u>Baschior, KS 66007</u>	
4. Locate with "X" in section below:  6. Bore hole dia. <u>8</u> in. Completion date <u>8-7-78</u> Well depth <u>120</u> ft.	
7. <input checked="" type="checkbox"/> Cable tool <input checked="" type="checkbox"/> Rotary <input type="checkbox"/> Driven <input type="checkbox"/> Dug <input type="checkbox"/> Hollow rod <input type="checkbox"/> Jetted <input type="checkbox"/> Bored <input type="checkbox"/> Reverse rotary	
8. Use: <input checked="" type="checkbox"/> Domestic <input type="checkbox"/> Public supply <input type="checkbox"/> Industry <input type="checkbox"/> Irrigation <input type="checkbox"/> Air conditioning <input type="checkbox"/> Stock <input type="checkbox"/> Lawn <input type="checkbox"/> Oil field water <input type="checkbox"/> Other	
9. Casing: Material <u>PRC</u> Height: <u>Above</u> or below Threading: <u>Welded</u> Surface <u>24</u> in. RMP: <u>PVC Blue</u> Weight <u>2.74</u> lbs./ft. Dia. <u>5</u> in. to <u>120</u> ft. depth Wall Thickness: inches or Dia. in. to ft. depth gage No. <u>258</u>	
5. Type and color of material	10. Screen: Manufacturer's name <u>Pumped</u> Type <u>PRC</u> Dia. <u>5 1/2</u> Slit/sauze <u>90</u> Length <u>40'</u> Set between <u>20</u> ft. and <u>50</u> ft. <u>110</u> ft. and <u>120</u> ft. Gravel pack? <u>Yes</u> Size range of material <u>20/40</u>
<u>Brown Clay</u>	From <u>0</u> To <u>7</u>
<u>Brown Sandstone</u>	<u>7</u> <u>13</u>
<u>Gray Shale</u>	<u>13</u> <u>14</u>
<u>Brown Shale</u>	<u>14</u> <u>15</u>
<u>Brown Sandstone</u>	<u>15</u> <u>18</u>
<u>Brown Limestone</u>	<u>18</u> <u>22</u>
<u>Gray Shale</u>	<u>22</u> <u>28</u>
<u>Brown Shale</u>	<u>28</u> <u>29</u>
<u>Brown Limestone</u>	<u>29</u> <u>30</u>
<u>Gray Limestone</u>	<u>30</u> <u>41</u>
<u>Gray Shale & Limestone</u>	<u>41</u> <u>120</u>
11. Static water level: <u>34</u> ft. below land surface Date <u>8-7-78</u> mo./day/yr.	
12. Pumping level below land surfaces: <u>41 x Test</u> ft. after hrs. pumping g.p.m. Estimated maximum yield <u>20 GPM</u>	
13. Water sample submitted: <u>Yes</u> <input checked="" type="checkbox"/> No Date	
14. Well head completion: <u>Top Cap</u> Pitless adapter <u>24</u> inches above grade	
15. Well grouted? <u>Yes</u> With: <input checked="" type="checkbox"/> Neat cement <input type="checkbox"/> Bentonite <input type="checkbox"/> Concrete Depth: From <u>0</u> ft. to <u>10</u> ft.	
16. Nearest source of possible contamination: ft. <u>200</u> Direction <u>SW</u> Type <u>laterals</u> Well disinfected upon completion? <input checked="" type="checkbox"/> Yes <input type="checkbox"/> No	
17. Pump: <input checked="" type="checkbox"/> Not installed Manufacturer's name Model number HP Volts Length of drop pipe ft. capacity g.p.m. Type: <input type="checkbox"/> Submersible <input type="checkbox"/> Turbine <input type="checkbox"/> Jet <input type="checkbox"/> Reciprocating <input type="checkbox"/> Centrifugal <input type="checkbox"/> Other	
18. Elevation: <u>940</u> Topography: <u>Km</u> 19. Remarks: <u>Owner to install slab</u>	
20. Water well contractor's certification: This well was drilled under my jurisdiction and this report is true to the best of my knowledge and belief. <u>STRADER DAIG Co June 1972</u> Business name License No. Address <u>RT 1 Holton, KS</u> Signed <u>Dale Adam</u> Date <u>8-9-78</u> Authorized representative	

T 11 S R 22 EW 1 SE SE SE