243

USE TYPEWRITER OR BALL POINT PEN-PRESS FIRMLY, PRINT CLEARLY.

ADD

WATER WELL RECORD
KSA 82a-1201-1215

Kansas Department of Health and Environment-Division of Environment
(Water well Contractors)
Topeka, Kansas 66620

Right on line w/ DAB

1. Location of well:	County	Fraction	Section number	Township number	Range number
	Leavenworth	SE 1/4 SE 1/4 NE 1/4	29	T 11 S	R 22 E/W

2. Distance and direction from nearest town or city: 4 miles SW of Basehor, Kansas
Street address of well location if in city:

3. Owner of well: Mr. Tom Theno
R.R. or street: Route 2
City, state, zip code: Bonner Springs, Kansas

4. Locate with "X" in section below:

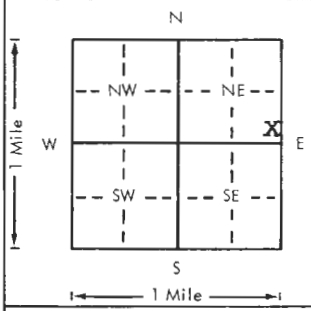

Sketch map:

5. Type and color of material	From	To
Top Soil	0	1
Sandstone - Yellow	1	10
Gumbo	10	15
Sandstone - Yellow Poor with little shale.	15	22
Shale	22	39
Sandstone -mYellow	39	47
Sandstone - Gray	47	60
Lime	60	64
Shale	64	65
Lime	65	68
Shale	68	72
Lime	72	89
Shale	89	95
Lime	95	100
(Use a second sheet if needed)		

6. Bore hole dia. 8 in. Completion date 9-26-78
Well depth 100 ft.

7. __ Cable tool X Rotary __ Driven __ Dug
__ Hollow rod __ Jetted __ Bored __ Reverse rotary

8. Use: X Domestic __ Public supply __ Industry
__ Irrigation __ Air conditioning __ Stock
__ Lawn __ Oil field water __ Other

9. Casing: Material FL. Height: Above or below
Threaded ___ Welded X Surface 18 in.
RMP ___ PVC X Weight ___ lbs./ft.
Dia. 6 in. to 56 ft. depth Wall Thickness inches or
Dia. ___ in. to ___ ft. depth gage No. .280

10. Screen: Manufacturer's name NONE
Type ___ Dia. ___
Slot/gauze ___ Length ___
Set between ___ ft. and ___ ft.
___ ft. and ___ ft.
Gravel pack? NONE Size range of material ___

11. Static water level: mo./day/yr.
40 ft. below land surface Date 9-26-78

12. Pumping level below land surfaces:
___ ft. after ___ hrs. pumping ___ g.p.m.
___ ft. after ___ hrs. pumping ___ g.p.m.
Estimated maximum yield 2 g.p.m.

13. Water sample submitted: mo./day/yr.
___ Yes X No Date ___

14. Well head completion:
X Pitless adapter 18 Inches above grade

15. Well grouted? Yes
With X Neat cement ___ Bentonite ___ Concrete
Depth: From 3 ft. to 15 ft.

16. Nearest source of possible contamination:
ft. 150' Direction north Type septic
Well disinfected upon completion? X Yes ___ No

17. Pump: Not installed
Manufacturer's name Jacuzzi
Model number 5S4B HP 1/2 Volts 220
Length of drop pipe 90 ft. capacity 10 g.p.m.
Type:
X Submersible ___ Turbine
___ Jet ___ Reciprocating
___ Centrifugal ___ Other

18. Elevation: 932 DA
Topography:
___ Hill
___ Slope
___ Upland
___ Valley

19. Remarks:
m SHOT WELL. STORAGE 400 GALLONS

20. Water well contractor's certification:
This well was drilled under my jurisdiction and this report is true to the best of my knowledge and belief.
BREUER, INC. 174
Business name License No.
Address Box 147, Basehor, Ks.
Signed [signature] Date 9-27-78
Authorized representative

T 11 R 22 E/W Sec 29 1/4 SE 1/4 SE 1/4 NE 1/4

Forward the white, blue and pink copies to the Department of Health and Environment

Form WWC-5

BR = 917
$ = 892.

M1-1023