


1 LOCATION OF WATER WELL: Fraction SE 1/4 SE 1/4 SE 1/4 Section Number 36 Township Number T 11 S Range Number R 22 EW
 County: LEVENWORTH

Distance and direction from nearest town or city street address of well if located within city?
1 MILE SW OF BONNER SPRINGS, KS.

2 WATER WELL OWNER: TONY SCHOETZ
 RR#, St. Address, Box #: P.O. BOX 86 Board of Agriculture, Division of Water Resources
 City, State, ZIP Code: BONNER SPRINGS KS 66012 Application Number:

3 LOCATE WELL'S LOCATION WITH AN "X" IN SECTION BOX:

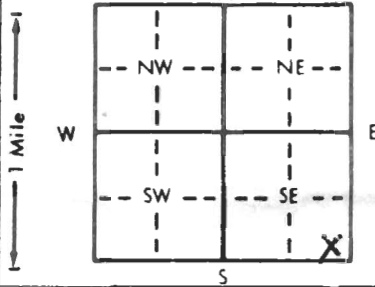

4 DEPTH OF COMPLETED WELL: 100 ft. ELEVATION:

Depth(s) Groundwater Encountered 1. 32 ft. 2. ft. 3. ft.
 WELL'S STATIC WATER LEVEL 28 ft. below land surface measured on mo/day/yr 8/17/91
 Pump test data: Well water was ft. after hours pumping gpm
 Est. Yield 15 gpm; Well water was ft. after hours pumping gpm
 Bore Hole Diameter 8 1/2 in. to 100 ft., and in. to ft.
 WELL WATER TO BE USED AS: 5 Public water supply 8 Air conditioning 11 Injection well
 Domestic 3 Feedlot 6 Oil field water supply 9 Dewatering 12 Other (Specify below)
 Irrigation 4 Industrial 7 Lawn and garden only 10 Monitoring well
 Was a chemical/bacteriological sample submitted to Department? Yes. No. ; If yes, mo/day/yr sample was submitted
 Water Well Disinfected? Yes No

5 TYPE OF BLANK CASING USED: 5 Wrought iron 8 Concrete tile CASING JOINTS: Glued Clamped
 1 Steel 3 RMP (SR) 6 Asbestos-Cement 9 Other (specify below) Welded
 PVC 4 ABS 7 Fiberglass Threaded

Blank casing diameter 5 1/2 in. to 25 ft., Dia. in. to ft., Dia. in. to ft.
 Casing height above land surface 12 in., weight SDR-26 lbs./ft. Wall thickness or gauge No.

TYPE OF SCREEN OR PERFORATION MATERIAL: 7 PVC 10 Asbestos-cement
 1 Steel 3 Stainless steel 5 Fiberglass 8 RMP (SR) 11 Other (specify) SAW SLOT
 2 Brass 4 Galvanized steel 6 Concrete tile 9 ABS 12 None used (open hole)

SCREEN OR PERFORATION OPENINGS ARE: 5 Gauzed wrapped Saw cut 11 None (open hole)
 1 Continuous slot 3 Mill slot 6 Wire wrapped 9 Drilled holes
 2 Louvered shutter 4 Key punched 7 Torch cut 10 Other (specify)

SCREEN-PERFORATED INTERVALS: From 100 ft. to 25 ft., From ft. to ft.
 GRAVEL PACK INTERVALS: From 100 ft. to 25 ft., From ft. to ft.

6 GROUT MATERIAL: Neat cement 2 Cement grout 3 Bentonite 4 Other
 Grout Intervals: From 24 ft. to 3 ft., From ft. to ft., From ft. to ft.

What is the nearest source of possible contamination:
 Septic tank 4 Lateral lines 7 Pit privy 10 Livestock pens 14 Abandoned water well
 Sewer lines 5 Cess pool 8 Sewage lagoon 11 Fuel storage 15 Oil well/Gas well
 3 Watertight sewer lines 6 Seepage pit 9 Feedyard 12 Fertilizer storage 16 Other (specify below)
 13 Insecticide storage
 Direction from well? How many feet? 150'

FROM	TO	LITHOLOGIC LOG	FROM	TO	PLUGGING INTERVALS
0	3	FILL			
3	4	TOPSOIL			
4	30	CLAY			
20	32	SANDY CLAY CHANGING TO COARSE GRAVEL			
32	72	LIME			
72	76	SHALE BLACK			
76	92	LIME			
92	100	SHALE			

7 CONTRACTOR'S OR LANDOWNER'S CERTIFICATION: This water well was (1) constructed, (2) reconstructed, or (3) plugged under my jurisdiction and was completed on (mo/day/year) 8/15/91 and this record is true to the best of my knowledge and belief. Kansas
 Water Well Contractor's License No. 240 This Water Well Record was completed on (mo/day/yr) 8/25/91
 under the business name of FF YOUNG DRILLING CO by (signature) Red Young

INSTRUCTIONS: Use typewriter or ball point pen. PLEASE PRESS FIRMLY and PRINT clearly. Please fill in blanks, underline or circle the correct answers. Send three copies to Kansas Department of Health and Environment, Bureau of Water, Topeka, Kansas 66620-7320. Telephone: 913-296-5545. Send one to WATER WELL OWNER and retain one for your records.