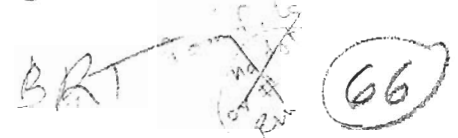


11-23-7 ADD EL = N920

# WATER WELL RECORD

White: Driller's copy  
 Blue: Mail to Missouri Geological Survey  
 Pink: For well owner

BRT  
  
 66

## DRILLERS LOG OF WELL

Kind of rock, color, hard, or soft etc.	From (ft.)	To (ft.)
Top Soil	0	5
Clay yellow	5	12
Clay & Rock hard-pan	12	22
Boulders	22	24
Rock & Gravel	24	29
Sand or Limestone solid	29	32
Shale - rock mixed	32	105
Sandstone gray	105	120
Shale gray	120	127
Sandy Shale gray	127	143
Sandstone gray	143	149
Line average	149	155

## IMPORTANT DATA

Location of Well County Leavenworth  
 (Show location in Section Plat)

SESENE 1  
 1/4 Sec. 17  
11S 22  
 T. 11S R. 22 E. W.

Total depth \_\_\_\_\_ Elev. 865  
*El. along low road*

Well Owner Paul McKee

Address Tonganoxie, Kansas

Mileage and direction from nearest town or highway \_\_\_\_\_

Drilling Contractor Cullum & Brown Drilling Co.

Address 1240 Burlington N.K.C., Mo.

Date Drilled 3/27/64

Method of Drilling Cable 22W  
 (Cable tool, rotary, reverse rotary, etc.)

Casing Schedule 69' used 6 1/2" 9 1/2' - 5 1/2"  
 (Amount, Size, Setting - New, Used - Steel, Galv., - Gage or Weight)

Screen Data (if any): \_\_\_\_\_  
 (Length, Diameter, Slot Size, Setting)

Measured depth to water on completed well (Static Level)  
 is 15 ft. below \_\_\_\_\_  
 (Land Surface, Top of Casing Etc.)

Tested Yield 10 est. gallons per min  
 (Min., Hour)

as determined by \_\_\_\_\_  
 (Bailing, Test Pumping, Etc.)

Drawdown \_\_\_\_\_ ft. after \_\_\_\_\_ hrs.  
 pumping at \_\_\_\_\_ gal. per minute

Remarks BR = 81'  
Barometer Springs  
Topo