

*VBRT  
Top Ken*

# WATER WELL RECORD

## DRILLERS LOG OF WELL

FROM (FT.)	TO (FT.)	KIND OF MATERIAL, COLOR, ETC. (NOTE WATER ZONES, AMOUNT, QUALITY)
0	1	Sandy Clay
1	32	Sandstone (yellow soft)
32	36	Sandy Shale
36	40	Sandstone
40	52	Lime
52	57	Black Slate
57	62	Lime
62	81	Shale
81	97	Lime
97	124	Shale
124	125	Lime
125	T.D.	

Well Owner Mr. Gene Owens

Address Tract No. 4 Basehor, Ks.

Drilling Contractor Breuer Drilling Co.  
Basehor, Ks.

Date Drilled 12-22-71

Method of Drilling Air Rotary  
(Cable tool, rotary, reverse rotary, etc.)

Casing Schedule 125 ft. 6 in. plastic  
(Amount, Size, Setting—New, Used—Steel, Galv.—Gage or Weight)

Screen Data (if any): \_\_\_\_\_  
(Length, Diameter, Slot Size, Setting)

Measured depth to water on completed well (Static Level) is  
25 ft. below land surface  
(Land Surface, Top of Casing, Etc.)

TESTED YIELD:  $\frac{1}{2}$  gallons per min.  
(Min., Hour)

as determined by air test  
(Bailing, Test Pumping, Etc.)


DRAWDOWN: \_\_\_\_\_ ft. after \_\_\_\_\_ hrs.

pumping at \_\_\_\_\_ gal. per minute.

REMARKS:

c b c

LOCATION OF WELL Topographic Sheet B 5499  
[Show location in Section Plat] Elev. 920.4'

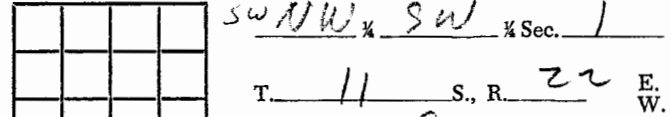

BR = 919210

"To preserve water well information and to promote the conservation, protection, and development of ground-water resources."