

TOP Kan
Studies
Map

11-22-266 BRT
no map location
entered in complete

WATER WELL RECORD

DRILLERS LOG OF WELL

FROM (FT.)	TO (FT.)	KIND OF MATERIAL, COLOR, ETC. (NOTE WATER ZONES, AMOUNT, QUALITY)
0	2	Topsoil
2	20	Clay
20	30	Gravel Sand
30	40	Shale
40	58	Sand stone
	58	T.D.

Well Owner Mrs. Anne Brink
Address 3240 Forrest
Breuer Drilling Co.
Drilling Contractor _____
Date Drilled May 8, 1957
Method of Drilling Cable tool
Casing: Used Steel
(New, Used—Steel, Galv.—Gage or Weight)
Casing Schedule: 33 ft. 6 1/2
(Amount, Size, Setting)

Screen Data (if any): _____


ON COMPLETED WELL

Measured depth to water (Static Level) is 20 ft.
below land surface
(Land Surface, Top of Casing, Etc.)
TESTED YIELD: 5 gallons per min
(Min., Hour)
as determined by Bailing
(Bailing, Test Pumping, Etc.)
DRAWDOWN: _____ ft. after _____ hrs.
pumping at _____ gal. per minute.

REMARKS: _____

BBA

LOCATION OF WELL
[Show location in Section Plat] Elev. ± 953

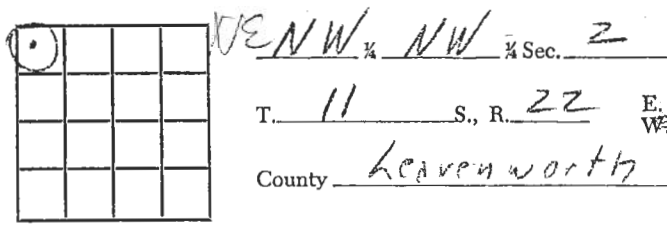

“To preserve water well information and to promote the conservation, protection, and development of ground-water resources.”