

DRILLERS LOG OF WELL

Well Owner Mrs. Murphy

Address Basehor, Kansas

Drilling Contractor Breuer Drilling Co.

Date Drilled 11-11-72

Method of Drilling Cable tool
(Cable tool, rotary, reverse rotary, etc.)

Casing Schedule 36 ft. 62 Plastic
(Amount, Size, Setting—New, Used—Steel, Galv.—Gage or Weight)

Screen Data (if any): _____
(Length, Diameter, Slot Size, Setting)

Measured depth to water on completed well (Static Level) is

30 ft. below Land Surface
(Land Surface, Top of Casing, Etc.)

TESTED YIELD: 3 gallons per Min.
(Min., Hour)

as determined by Bailing
(Bailing, Test Pumping, Etc.)

DRAWDOWN: _____ ft. after _____ hrs.

pumping at _____ gal. per minute.

REMARKS: Well was shot, before shot

well yield $1\frac{1}{4}$ gallon a Min.

After shot well yield 3 gallons

a min. There is 750 gallons

storage.

LOCATION OF WELL Topographic Sheet Bon Springs
[Show location in Section Plat] Elev. 940 +

SE SE $\frac{1}{4}$ SW $\frac{1}{4}$ Sec. 10

T. 11 S., R. 22 (E
W)

County Revermouth

BR=909 NP
3-910

[illegible]

KANSAS WELL SCHEDULE

Card 1

Sampled 5-1 1:56 Bolla 6515

Record by M. K. Kersch Date: 4-22 Project: Top-KC State: Kans K County: Leav 52

Latitude: _____ deg min sec Longitude: _____ deg min sec Accuracy: _____ Owner's well no: _____

Location: _____ SE SW no. sec. 10 T. 11 N., R. 22 Well number: 1122E10DE CDOwner: Draga Murphy R#2 address Box 137D B...Owner: DRAGA MURPHY Altitude: _____ Accuracy _____Driller: Bieuer address _____ Date drilled: 11/1-72Topography, well site: (D) Draw, (F) flood plain, (L) lowland, (R) rolling, (S) slope, (T) terrace, (U) upland, (V) Spring; or depth of well: 70 70 3Diameter: 6" 06 Depth cased: 36 36 Csg. type: Photo Finish: _____ Lift & power: sub. elec 0Pump setting: _____ Use of well: Domestic, stock, irrigation, industrial, public supply, observation, none, test _____Water level: 26.6 above lsd 26.6 1 4-27-72 073 Water level records avail. _____Description MP: Top Casing 1.0 above above lsd _____

Yield: _____ gpm _____ Pumping period: _____ hours or days _____ Specific capacity: _____ gpm/ft. dd _____

Pumpage and other data available: _____

Card 2

Coefficient trans: _____ gpd/ft _____ Coefficient storage: _____ Coefficient perm.: _____ gpd/ft².

Aquifer, system or series _____

Aquifer, units _____

Aquifer, thickness: _____ feet _____ Aquifer, length of well open to: _____ feet _____ Aquifer, depth to top of: _____ feet _____ Aquifer, origin: _____

Aquifer, lithology of: _____

Bedrock, system: _____ Bedrock, formation: _____ Bedrock, depth to: _____ feet _____

Surficial material: _____ lithology _____ infiltration characteristics _____ Log data avail: Drillers log A

Quality of water data available: _____ Temperature of water: _____ °F. _____ Date sampled: _____

Coefficient of leakage _____

Ownership category: (C) County, (F) Federal Gov't., (M) City, (N) Corp. or Co., (P) Private, (S) State Agency, (W) Water Dist. _____



Method drilled: (A) Air, (B) bored, (C) cable, (D) dug, (V) driven, (H) hyd. rotary, (J) jetted, (R) rev. rotary, (T) trenching, (S) spring, _____

Physiographic province: _____ Section: _____

Drainage basin: _____ Subbasin: _____ Depth to basement: _____ source of data (basement) _____

Quadrangle _____ Well no. 11-22E-10 CD

② w 2/1
30'

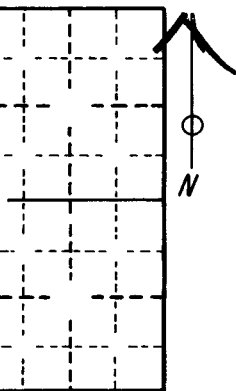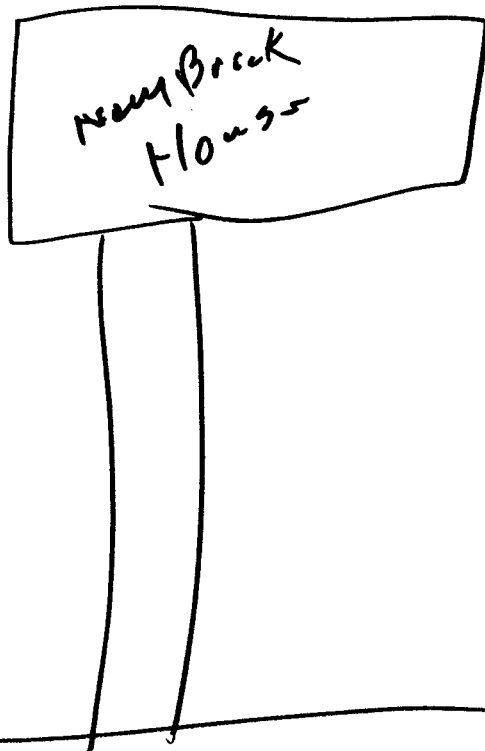

Paved Road