

WATER WELL RECORD

Form WWC-5

Division of Water Resources App. No.


Well ID

MW6

Original Record [ ] Correction [X] Change in Well Use [ ]

1 LOCATION OF WATER WELL: County Leavenworth, Fraction SE 1/4 SE 1/4 SE 1/4 SE 1/4, Section Number 27, Township Number T 11 S, Range Number R 22 E W

2 WELL OWNER: Last Name: Business: Maha, LLC, Address: 6833 N Oak, City: Gladstone, State: MO, ZIP: 64118, Street or Rural Address where well is located: 15621 158th St, Bonner Springs, KS

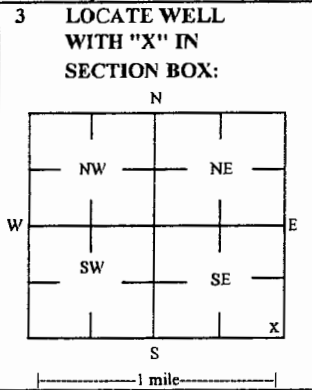

3 LOCATE WELL WITH "X" IN SECTION BOX: 4 DEPTH OF COMPLETED WELL: 22.5 ft, Depth(s) Groundwater Encountered: 1) 22.5 ft, 2) 7.10 ft, 3) Dry Well, 4) Dry Well, WELL'S STATIC WATER LEVEL: 7.10 ft, below land surface, measured on (mo-day-yr) 12/15/16

5 Latitude: 39.05838 (decimal degrees), Longitude: 94.94681 (decimal degrees), Horizontal Datum: [X] WGS 84, [ ] NAD 83, [ ] NAD 29, Source for Latitude/Longitude: [ ] GPS (unit make/model: ), [X] Land Survey, [ ] Topographic Map, [ ] Online Mapper

6 Elevation: 922.40 ft, Ground Level: [X] TOC, Source: [X] Land Survey, [ ] GPS, [ ] Topographic Map, [ ] Other

7 WELL WATER TO BE USED AS: 1 Domestic: [ ] Household, [ ] Lawn & Garden, [ ] Livestock, [ ] Irrigation, [ ] Feedlot, [ ] Industrial, 2 Public Water Supply: well ID, 3 Dewatering: how many wells?, 4 Aquifer Recharge: well ID, 5 Monitoring: well ID: MW6, 6 Environmental Remediation: well ID, 7 Air Sparge, 8 Soil Vapor Extractor, 9 Recovery, 10 Injection, 11 Oil Field Water Supply: lease, 12 Test Hole: well ID, 13 Cased, 14 Uncased, 15 Geotechnical, 16 Geothermal: How many bores?, 17 a) Closed Loop, 18 Horizontal, 19 Vertical, 20 b) Open Loop, 21 Surface Discharge, 22 Inj. of Water, 23 Other (specify):

Was a chemical/bacteriological sample submitted to KDHE? [ ] Yes [X] No, If yes, date sample was submitted: Water well disinfected? [ ] Yes [X] No

8 TYPE OF CASING USED: [ ] Steel [X] PVC [ ] Other, CASING JOINTS: [ ] Glued [ ] Clamped [ ] Welded [X] Threaded, Casing diameter: 2 in. to 7.5 ft, Diameter: in. to ft, Diameter: in. to ft, Casing height above land surface: -0.31 in., Weight: lbs./ft., Well thickness or gauge No: TYPE OF SCREEN OR PERFORATION MATERIAL: [ ] Steel [ ] Stainless Steel [ ] Fiberglass [X] PVC [ ] Brass [ ] Galvanized Steel [ ] Concrete tile [ ] None used (open hole), SCREEN OR PERFORATION OPENINGS ARE: [ ] Continuous Slot [X] Mill Slot [ ] Gauze Wrapped [ ] Torch Cut [ ] Drilled Holes [ ] Other (Specify), [ ] Louvered Shutter [ ] Key Punched [ ] Wire Wrapped [ ] Saw Cut [ ] None (Open Hole), SCREEN-PERFORATED INTERVALS: From 7.5 ft. to 22.5 ft., From ft. to ft., From ft. to ft., GRAVEL PACK INTERVALS: From 5 ft. to 22.5 ft., From ft. to ft., From ft. to ft.,

9 GROUT MATERIAL: [ ] Neat cement [ ] Cement grout [X] Bentonite [X] Other Concrete: 0-0.5", Grout intervals: From 0.5 ft. to 5 ft., From ft. to ft., From ft. to ft.,

Nearest source of possible contamination: [ ] Septic Tank [ ] Lateral Lines [ ] Pit Privy [ ] Livestock Pens [ ] Insecticide Storage, [ ] Sewer Lines [ ] Cess Pool [ ] Sewage Lagoon [X] Fuel Storage [ ] Abandoned Water Well, [ ] Watertight Sewer Lines [ ] Seepage Pit [ ] Feedyard [ ] Fertilizer Storage [ ] Oil Well / Gas Well, [ ] Other (Specify): Direction from well? E-NE, Distance from well? ~150 ft

Table with 6 columns: 10 FROM, 10 TO, LITHOLOGIC LOG, 10 FROM, 10 TO, LITHO. LOG (cont.) or PLUGGING INTERVALS. Rows include Topsoil, Silty clay, increasing silt, Sand, gravel, and clay, and Glacial till.

Notes: KDHE ID: Lake Stop; U4-052-14803

11 CONTRACTOR'S OR LANDOWNER'S CERTIFICATION: This water well was [X] constructed, [ ] reconstructed, or [ ] plugged under my jurisdiction and was completed on (mo-day-year) 12/13/16 and this record is true to the best of my knowledge and belief. Kansas Water Well Contractor's License No 757 This Water Well Record was completed on (mo-day-year) 2/15/17 under the business name of Larsen & Associates, Inc. Signature

# DENNIS L HANDKE

1820 NW 59th Terrace  
TOPEKA, KANSAS 66618  
785-286-4047 Home  
785-286-1990 Fax

Jessica Chapman  
Larsen & Associates  
1311 E. 25<sup>th</sup> Street, Suite B  
Lawrence, Kansas, 66046

February 14, 2017  
Revised February 16, 2017

RE: Monitor Well Elevation Survey  
15621 158<sup>th</sup> St., Bonner Springs, Kansas

Proj. 17-00D  
Lake Stop  
U4-052-14803

Bench Mark: Sq.cut on Southeast corner of concrete retaining wall of fuel storage tank, West of the parking lot.

Elev: 924.57      North 115      West 233      (from SE Cor. Sec. 27-11-22E)


MW-1	rim	924.39	North	158	SE1/4,SE1/4,SE1/4,SE1/4
	top pipe	924.06	West	61	Lat= 39.05857 Long = 94.94619
MW-2	rim	923.67	North	85	SE1/4,SE1/4,SE1/4,SE1/4
	top pipe	923.32	West	63	Lat= 39.05837 Long = 94.94621
MW-3	rim	924.19	North	121	SE1/4,SE1/4,SE1/4,SE1/4
	top pipe	923.94	West	167	Lat= 39.05847 Long = 94.94657
MW-4	rim	924.83	North	288	SE1/4,SE1/4,SE1/4,SE1/4
	top pipe	924.47	West	231	Lat= 39.05893 Long = 94.94679
MW-5	rim	929.83	North	132	SW1/4,SW1/4,SW1/4,SW1/4 (26-11-22)
	top pipe	929.53	West	46	Lat= 39.05850 Long = 94.94582
MW-6	rim	922.71	North	86	SE1/4,SE1/4,SE1/4,SE1/4
	top pipe	922.40	West	236	Lat= 39.05838 Long = 94.94681

Elevation derived from Wyandotte County bench mark: WY 48, NAVD 88.

Lat & Long derived from Bonner Springs 7.5 Quad Map WGS84.

If you have any questions, please feel free to call me. Thank you for the opportunity to be of service to you.

February 16, 2017  
Dennis L Handke RLS

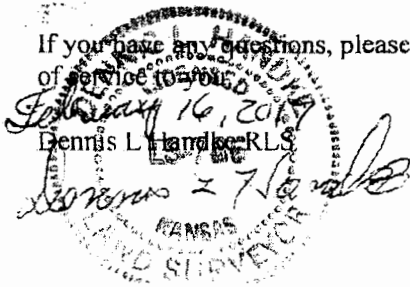

RECEIVED  
FEB 24 2017  
BUREAU OF WATER