

WATER WELL PLUGGING RECORD

Form WWC-5P

KSA 82a-1212

ID NO.

MW5

1 LOCATION OF WATER WELL: County: Leavenworth	Fraction SW ¼ SW ¼ SW ¼ SW ¼	Section Number 26	Township Number T 11 S	Range Number 22 X E W
---	---------------------------------	----------------------	---------------------------	--------------------------

Street/Rural Address of Well Location: if unknown, distance & direction from nearest town or intersection: If at owner's address, check here ☐

15774 Linwood Rd., Bonner Springs, KS

Global Positioning Systems (GPS) information:

Latitude: NA (in decimal degrees)

Longitude: NA (in decimal degrees)

Elevation: NA

Horizontal Datum ☐ WGS84, ☐ NAD83, ☐ NAD27

Collection Method:

☐ GPS unit (Make/model):☐ Digital Map/Photo, ☐ Topographic Map ☐ Land SurveyEst. Accuracy: ☐ <3 m, ☐ 3-5 m, ☐ 5-15 m, ☐ >15 m**2 WATER WELL OWNER:**

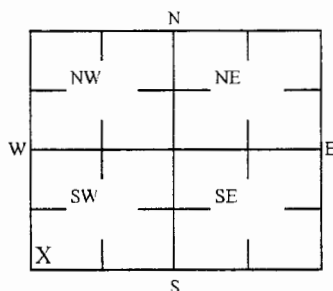
Maha, LLC

RR#, St. Address, Box #:

6833 N Oak

City, State ZIP Code:

Gladstone, MO 64118

3 MARK WELL'S LOCATION WITH AN "X" IN SECTION BOX:**4 DEPTH OF WELL** 25.30 **ft. MW5**

WELL'S STATIC WATER LEVEL NA ft

WELL WAS USED AS:

☐ Domestic
☐ Irrigation
☐ Feedlot
☐ Industrial

☐ Public Water Supply
☐ Oil Field Water Supply
☐ Domestic (Lawn & Garden)
☐ Air Conditioning

☐ Dewatering
☒ Monitoring
☐ Injection Well
☐ Other

Was a chemical/bacteriological sample submitted to Department?

Yes ☐ No ☒**5 TYPE OF BLANK CASING USED:**
☐ Steel
☒ PVC

☐ RMP (SR)
☐ ABS

☐ Wrought
☐ Asbestos-Cement

☐ Fiberglass
☐ Concrete Tile
☐ Other (Specific below)

Blank casing diameter 2 in.

Was casing pulled? Yes ☒ No ☐

If yes, how much 3ft

Casing high above or below land surface NA in.

6 GROUT PLUG MATERIAL:☐ Neat cement☐ Cement grout☒ Bentonite☒ Other

Grass seed & soil: 0-0.5ft

Grout Plug Intervals: From 0.5 ft to 25.30 ft, From ft to ft, From ft to ft

What is the nearest source of possible contamination:

☐ Septic tank
☐ Sewer lines
☐ Watertight sewer lines
☐ Lateral lines
☐ Cess pool

☐ Seepage pit
☐ Pit privy
☐ Sewage lagoon
☐ Feed yard
☐ Livestock pens

☐ Fuel storage
☐ Fertilizer storage
☐ Insecticide storage
☐ Abandoned water well
☐ Oil well/Gas well
☐ Other (specify below)

Direction from well?

How many feet?

FROM	TO	PLUGGING MATERIALS	FROM	TO	PLUGGING MATERIALS
0	0.5	Grass seed & Soil			
0.5	25.30	Bentonite			

KDHE ID: Lake Stop: U4-052-14803

7 CONTRACTOR'S OR LANDOWNER'S CERTIFICATION:

This water well was plugged under my jurisdiction and was completed on (mo/day/year) 6/21/2018 and this record is true to the best of my knowledge and belief. Kansas Water Contractor's License No. 757. This Water Well Record was completed on (mo/day/year) 6/25/2018 under the business name of Larsen & Associates, Inc. By (signature)

Send one white copy to Kansas Department of Health & Environment, Geology Section, 1000 S.W. Jackson, Suite 420, Topeka, KS 66612-1367. Send one copy to WATER WELL OWNER and retain one for your records

Visit us at <http://www.kdheks.gov/waterwell/index.html> Telephone 785-296-5524.

KSA82a-1212

Revised 1/20/2015