


1 LOCATION OF WATER WELL: Fraction NE 1/4 NE 1/4 NW 1/4 Section Number 10 Township Number T 11 S Range Number R 23 E
 County: Wyandotte

Distance and direction from nearest town or city street address of well if located within city?
.4 East of 118th st. on State NE, South Side

2 WATER WELL OWNER: Kansas International Speedway Corp
 RR#, St. Address, Box #: 1333 Meadowlark Lane Suite 201 Board of Agriculture, Division of Water Resources
 City, State, ZIP Code: Kansas City, KS 66102 Application Number:

3 LOCATE WELL'S LOCATION WITH AN "X" IN SECTION BOX: 4 DEPTH OF COMPLETED WELL: 27 ft. ELEVATION:

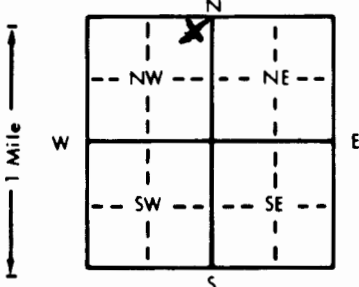

Depth(s) Groundwater Encountered 1. . ft. 2. . ft. 3. . ft.
 WELL'S STATIC WATER LEVEL 16 ft. below land surface measured on mo/day/yr 4-12-99
 Pump test data: Well water was . ft. after . hours pumping . gpm
 Est. Yield 8 gpm; Well water was . ft. after . hours pumping . gpm
 Bore Hole Diameter 36 in. to 27 ft., and . in. to . ft.
 WELL WATER TO BE USED AS:
 Domestic 3 Feedlot 6 Oil field water supply 9 Dewatering 12 Other (Specify below)
 2 Irrigation 4 Industrial 7 Lawn and garden only 10 Monitoring well
 Was a chemical/bacteriological sample submitted to Department? Yes . No If yes, mo/day/yr sample was submitted
 Water Well Disinfected? Yes No

5 TYPE OF BLANK CASING USED:
 1 Steel 3 RMP (SR) 6 Asbestos-Cement 9 Other (specify below)
 2 PVC 4 ABS 7 Fiberglass
 CASING JOINTS: Glued . Clamped .
 Welded .
 Threaded .
 Blank casing diameter . in. to . ft., Dia . in. to . ft., Dia . in. to . ft.
 Casing height above land surface . in., weight . lbs./ft. Wall thickness or gauge No. .

TYPE OF SCREEN OR PERFORATION MATERIAL:
 1 Steel 3 Stainless steel 5 Fiberglass 8 RMP (SR) 10 Asbestos-cement
 2 Brass 4 Galvanized steel 6 Concrete tile 9 ABS 12 None used (open hole)
 11 Other (specify) .

SCREEN OR PERFORATION OPENINGS ARE:
 1 Continuous slot 3 Mill slot 5 Gauzed wrapped 8 Saw cut 11 None (open hole)
 2 Louvered shutter 4 Key punched 6 Wire wrapped 9 Drilled holes
 7 Torch cut 10 Other (specify) .

SCREEN-PERFORATED INTERVALS: From . ft. to . ft., From . ft. to . ft., From . ft. to . ft.
 GRAVEL PACK INTERVALS: From . ft. to . ft., From . ft. to . ft., From . ft. to . ft.

6 GROUT MATERIAL: 1 Neat cement 2 Cement grout Bentonite 4 Other .
 Grout intervals: From 6 ft. to 5 ft., From . ft. to . ft., From . ft. to . ft., From . ft. to . ft.

What is the nearest source of possible contamination:
 1 Septic tank 4 Lateral lines 7 Pit privy 10 Livestock pens 14 Abandoned water well
 2 Sewer lines 5 Cess pool 8 Sewage lagoon 11 Fuel storage 15 Oil well/Gas well
 3 Watertight sewer lines 6 Seepage pit 9 Feedyard 12 Fertilizer storage 16 Other (specify below)
 13 Insecticide storage .

Direction from well? How many feet?

FROM	TO	LITHOLOGIC LOG	FROM	TO	PLUGGING INTERVALS
			<u>27</u>	<u>16</u>	<u>Chlorinated Sand, well lining</u>
			<u>16</u>	<u>6</u>	<u>Compacted Clay</u>
			<u>6</u>	<u>5</u>	<u>Bentonite</u>
			<u>5</u>	<u>0</u>	<u>Clay, Soil</u>

7 CONTRACTOR'S OR LANDOWNER'S CERTIFICATION: This water well was (1) constructed, (2) reconstructed, or plugged under my jurisdiction and was completed on (mo/day/year) 4-12-99 and this record is true to the best of my knowledge and belief. Kansas Water Well Contractor's License No. 561 This Water Well Record was completed on (mo/day/yr) 4-13-99 under the business name of EVANS Energy Dev. Inc. by (signature) [Signature]

OFFICE USE ONLY
T
R
EW
SEC
1/4
1/4
1/4