


1 LOCATION OF WATER WELL: County: Wyandotte Fraction: SW 1/4 NW 1/4 NW 1/4 Section Number: 10 Township Number: T 11 S Range Number: R 23 E

Distance and direction from nearest town or city street address of well if located within city?  
2 South of State Ave on 118th Street then 200' East - 821 N. 118th St.

2 WATER WELL OWNER: Kansas International Speedway Corp.  
 RR#, St. Address, Box #: 1333 Meadowlark Lane Suite 201  
 City, State, ZIP Code: Kansas City KS 66102  
 Board of Agriculture, Division of Water Resources  
 Application Number:

3 LOCATE WELL'S LOCATION WITH AN "X" IN SECTION BOX:

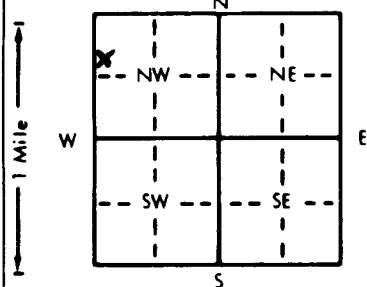

4 DEPTH OF COMPLETED WELL: 110 ft. ELEVATION:

Depth(s) Groundwater Encountered: 1. 63-65 ft. 2. \_\_\_\_\_ ft. 3. \_\_\_\_\_ ft.  
 WELL'S STATIC WATER LEVEL: 54 ft. below land surface measured on mo/day/yr 9-23-99  
 Pump test data: Well water was \_\_\_\_\_ ft. after \_\_\_\_\_ hours pumping \_\_\_\_\_ gpm  
 Est. Yield: 4 gpm Well water was \_\_\_\_\_ ft. after \_\_\_\_\_ hours pumping \_\_\_\_\_ gpm  
 Bore Hole Diameter: 8 1/4 in. to 110 ft., and \_\_\_\_\_ in. to \_\_\_\_\_ ft.  
 WELL WATER TO BE USED AS:  
 1 Domestic     2 Irrigation     3 Feedlot     4 Industrial  
 5 Public water supply     6 Oil field water supply     7 Lawn and garden only     8 Air conditioning     9 Dewatering     10 Monitoring well  
 11 Injection well     12 Other (Specify below)  
 Was a chemical/bacteriological sample submitted to Department? Yes \_\_\_\_\_ No X If yes, mo/day/yr sample was sub-  
 mitted Water Well Disinfected? Yes X No

5 TYPE OF BLANK CASING USED:  
 1 Steel     2 PVC     3 RMP (SR)     4 ABS     5 Wrought iron     6 Asbestos-Cement     7 Fiberglass     8 Concrete tile     9 Other (specify below)     10 Asbestos-cement

Blank casing diameter: 5 in. to 6-60 ft. Dia. 5 in. to 78-110 ft. Dia. \_\_\_\_\_ in. to \_\_\_\_\_ ft.  
 Casing height above land surface: \_\_\_\_\_ in. weight \_\_\_\_\_ lbs./ft. Wall thickness or gauge No. \_\_\_\_\_

TYPE OF SCREEN OR PERFORATION MATERIAL:  
 1 Steel     2 Brass     3 Stainless steel     4 Galvanized steel     5 Fiberglass     6 Concrete tile     7 PVC     8 RMP (SR)     9 ABS     10 Asbestos-cement     11 Other (specify)     12 None used (open hole)

SCREEN OR PERFORATION OPENINGS ARE:  
 1 Continuous slot     2 Mill slot 30,000     3 Louvered shutter     4 Key punched     5 Gauzed wrapped     6 Wire wrapped     7 Torch cut     8 Saw cut     9 Drilled holes     10 Other (specify)     11 None (open hole)

SCREEN-PERFORATED INTERVALS: From 60 ft. to 70 ft., From \_\_\_\_\_ ft. to \_\_\_\_\_ ft.  
 From \_\_\_\_\_ ft. to \_\_\_\_\_ ft., From \_\_\_\_\_ ft. to \_\_\_\_\_ ft.  
 GRAVEL PACK INTERVALS: From 110 ft. to 20 ft., From \_\_\_\_\_ ft. to \_\_\_\_\_ ft.  
 From \_\_\_\_\_ ft. to \_\_\_\_\_ ft., From \_\_\_\_\_ ft. to \_\_\_\_\_ ft.

6 GROUT MATERIAL:  1 Neat cement     2 Cement grout     3 Bentonite     4 Other  
 Grout Intervals: From 20 ft. to 0 ft., From \_\_\_\_\_ ft. to \_\_\_\_\_ ft., From \_\_\_\_\_ ft. to \_\_\_\_\_ ft.

What is the nearest source of possible contamination:  
 1 Septic tank     2 Sewer lines     3 Watertight sewer lines     4 Lateral lines     5 Cess pool     6 Seepage pit     7 Pit privy     8 Sewage lagoon     9 Feedyard     10 Livestock pens     11 Fuel storage plugged →  12 Abandoned water well     13 Insecticide storage     14 Oil well/Gas well     15 Fertilizer storage     16 Other (specify below)

Direction from well? West How many feet? 75

FROM	TO	LITHOLOGIC LOG	FROM	TO	PLUGGING INTERVALS
0	38	So. 1/2 Clay			
38	40	gravel			
40	43	Shale			
43	65	Sand			
65	70	Sandy Limestone			
70	75	Limestone			
75	77	Shale			
77	81	Limestone			
81	87	Shale			
87	100	Limestone			
100	105	Shale			
105	110	Limestone			

7 CONTRACTOR'S OR LANDOWNER'S CERTIFICATION: This water well was  (1) constructed, (2) reconstructed, or (3) plugged under my jurisdiction and was completed on (mo/day/year) 9-23-99 and this record is true to the best of my knowledge and belief. Kansas Water Well Contractor's License No. 561 This Water Well Record was completed on (mo/day/yr) 9-31-99 under the business name of Evans Energy Dev. Inc. by (signature) [Signature]