

1	LOCATION OF WATER WELL: County: <u>WY.</u>	Fraction <u>NE 1/4 NE 1/4 NE 1/4</u>	Section Number <u>21</u>	Township Number <u>11</u>	Range Number <u>23 E</u>
---	-----------------------------------------------	-----------------------------------------	-----------------------------	------------------------------	-----------------------------

Distance and direction from nearest town or city street address of well if located within city?

2 WATER WELL OWNER: Rich & Carol Schaefer
 RR#, St. Address, Box #: 3830 No 55 9th St.
 City, State, ZIP Code: K.C., KS 66104

Board of Agriculture, Division of Water Resources
 Application Number:

3 MARK WELL'S LOCATION WITH AN "X" IN SECTION BOX:
 N

	N W		N E
W			E
	S W		S E

 S

4 DEPTH OF WELL.....20 ft.
 WELL'S STATIC WATER LEVEL.....10 ft. SEE ATTACHED
 WELL WAS USED AS:
 1 Domestic 5 Public Water Supply 9 Dewatering
 2 Irrigation 6 Oil Field Water Supply 10 Monitoring Well
 3 Feedlot 7 Lawn and Garden Only 11 Injection Well
 4 Industrial 8 Air Conditioning 12 Other.....

Was a chemical/bacteriological sample submitted to Department? Yes.....No
 If yes; mo/day/yr sample was submitted.....
 Water Well Disinfected: Yes No.....

5 TYPE OF BLANK CASING USED:
 1 Steel 3 RMP (SR) 5 Wrought 7 Fiberglass 9 Other (specify below)
 2 PVC 4 ABS 6 Asbestos-Cement 8 Concrete Tile NON-F.

Blank casing diameter.....36 in. Was casing pulled? Yes..... No..... If yes, how much.....
 Casing height above or below land surface.....40 in.

6 GROUT PLUG MATERIAL: 1 Neat cement 2 Cement grout 3 Bentonite 4 Other.....CLAY

GROUT PLUG INTERVALS: From 6.5 ft. to 5.5 ft., From.....ft. to.....ft., From..... to.....ft.

What is the nearest source of possible contamination: N/A

1 Septic tank 6 Seepage pit 11 Fuel storage 16 Other (specify below)
 2 Sewer lines 7 Pit privy 12 Fertilizer storage
 3 Watertight sewer lines 8 Sewage lagoon 13 Insecticide storage
 4 Lateral lines 9 Feedyard 14 Abandoned water well
 5 Cess Pool 10 Livestock pens 15 Oil well/Gas well

Direction from well? How many feet?

FROM	TO	PLUGGING MATERIALS
10	6.5	rock + soil
6.5	5.5	bentonite
5.5	0	surface soil

Wyandotte Conservation
9400 State Ave
Room 117
KC KS 66112
 Attn: Amy

7 CONTRACTOR'S OR LANDOWNER'S CERTIFICATION: This water well was plugged under my jurisdiction and was completed on (mo/day/year)..... and this record is true to the best of my knowledge and belief. Kansas Water Well Contractor's License No. 4102 This Water Well Record was completed on (mo/day/year)..... under the business name of HARRY BOHNER EXCAVATING CO. INC.
 by (signature) [Signature]

INSTRUCTIONS: Use typewriter or ball point pen. Please press firmly and print clearly. Please fill in blanks, underline or circle the correct answers. Send top three copies to Kansas Department of Health and Environment, Bureau of Water, Topeka, Kansas 66620-0001. Telephone: 785/296-3565. Send one to Water Well Owner and retain one for your records.


**NPS POLLUTION CONTROL FUND
ABANDONED WATER WELL COST-SHARE PROGRAM
WELL PLUGGING WORKSHEET**

WORKSHEET: (Use water quality bulletin to complete this worksheet, available through Cooperative Extension Service.)

County Wyandotte Date Sept. 13, 2001

Type of Well: Drilled or Hand-Dug (Circle One)

Diameter 36 inches Depth to water 3'6" ft. Total Depth 10 ft.

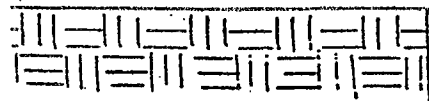


SOIL: 3 ft. Drilled
4.5 ft. Hand-dug

ROCK: 3 ft. Drilled (Minimum)
6 in. Hand-dug (Minimum)

WATER/SUBSOIL:
1 ft.

ROCK:
6'5" ft.

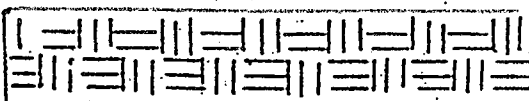

TOPSOIL: Material Needed **
7.07 cu. ft. 2 ft. of fill = 14.14 cu. ft.

PLUG:
7.07 cu. ft. * x 5 ft. of plug = 3.03 cu. ft. 2 1/2 bags
plug
_____ cu. ft. outside drilled well
to restore grout seal.

Handdug well, use diameter of well
after removal of rock lining.

SUBSOIL:
7.07 cu. ft./ft. * x 1 ft. of fill = 7.07 cu. ft.
subsoil

CHLORINE:
64.70 oz./ft. x 6.5 ft. of water = 420.5 oz. 3.28 gal
4 gal

SAND:
7.07 cu. ft./ft. x 6.5 ft. of sand = 45.9 cu. ft. = 1.70 cu. yd.
27

* Obtain cu. ft./ft. value from Extension Bulletin
"Plugging Abandoned Wells"

** 27 cu. ft. = 1 yard

SITE PREPARATION: REMOVE PUMP AND COLUMN PIPE AND DEBRIS. EXCAVATE AROUND DRILLED WELL CASING AND CUT CASING 3 FEET BELOW GROUND LEVEL. STOCKPILE FILL MATERIAL ON SITE. LEAVE IN TRUCK IF POSSIBLE. HANDDUG WELLS NEED TRACTOR WITH FRONT END LOAD OR LARGE PRY BARS TO CAVE IN ROCK LINING.

RECEIVED

APR 18 2002