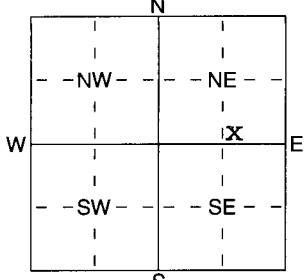


1 LOCATION OF WATER WELL: County: Wyandotte	Fraction SW ¼ SE ¼ NE ¼	Section Number 16	Township Number T 11 S	Range Number R 23E E/W
---	-----------------------------------	-----------------------------	----------------------------------	----------------------------------

Distance and direction from nearest town or city street address of well if located within city?
2 miles north 1 mile east of Piper

2 WATER WELL OWNER: **Betty Daly**
 RR#, St. Address, Box # : **11732 Hubbard Rd.**
 City, State, ZIP Code : **Kansas City, Ks. 66109**
 Board of Agriculture, Division of Water Resources
 Application Number: _____

3 LOCATE WELL'S LOCATION WITH AN "X" IN SECTION BOX: 	4 DEPTH OF COMPLETED WELL 98 ft. ELEVATION: _____ Depth(s) Groundwater Encountered 1 ft. 2 ft. 3 ft. WELL'S STATIC WATER LEVEL 6.5 ft. below land surface measured on mo/day/yr 10-21-2002 Pump test data: Well water was ft. after hours pumping gpm Est. Yield 20 gpm: Well water was ft. after hours pumping gpm WELL WATER TO BE USED AS: 1 Domestic 2 Irrigation 3 Feedlot 4 Industrial 5 Public water supply 6 Oil field water supply 7 Domestic (lawn & garden) 8 Air conditioning 9 Dewatering 10 Monitoring well 11 Injection well 12 Other (Specify below) Was a chemical/bacteriological sample submitted to Department? Yes No X; If yes, mo/day/yr sample was submitted Water Well Disinfected? Yes X No
--	--

5 TYPE OF BLANK CASING USED:
 1 Steel 2 PVC 3 RMP (SR) 4 ABS 5 Wrought iron 6 Asbestos-Cement 7 Fiberglass 8 Concrete tile 9 Other (specify below)
 CASING JOINTS: Glued **X** Clamped Welded Threaded

Blank casing diameter **5** in. to ft., Dia in. to ft., Dia in. to ft.
 Casing height above land surface **24** in., weight **2.82** lbs./ft. Wall thickness or guage No. **258**

TYPE OF SCREEN OR PERFORATION MATERIAL:
 1 Steel 2 Brass 3 Stainless Steel 4 Galvanized Steel 5 Fiberglass 6 Concrete tile 7 PVC 8 RMP (SR) 9 ABS 10 Asbestos-Cement 11 Other (Specify) 12 None used (open hole)

SCREEN OR PERFORATION OPENINGS ARE:
 1 Continuous slot 2 Louvered shutter 3 Mill slot 4 Key punched 5 Guazed wrapped 6 Wire wrapped 7 Torch cut 8 Saw cut 9 Drilled holes 10 Other (specify) 11 None (open hole)

SCREEN-PERFORATED INTERVALS: From **8.3** ft. to **9.8** ft., From ft. to ft.
 GRAVEL PACK INTERVALS: From **2.4** ft. to **9.8** ft., From ft. to ft.

6 GROUT MATERIAL: 1 Neat cement 2 Cement grout 3 Bentonite 4 Other

Grout Intervals: From **24** ft. to **9.8** ft., From ft. to ft., From ft. to ft.

What is the nearest source of possible contamination:
 1 Septic tank 2 Sewer lines 3 Watertight sewer lines 4 Lateral lines 5 Cess pool 6 Seepage pit 7 Pit privy 8 Sewage lagoon 9 Feedyard 10 Livestock pens 11 Fuel storage 12 Fertilizer storage 13 Insecticide storage 14 Abandoned water well 15 Oil well/Gas well 16 Other (specify below)
 Direction from well? **East** How many feet? **150**

FROM	TO	LITHOLOGIC LOG	FROM	TO	PLUGGING INTERVALS
0	2	top soil			
2	11	brown clay			
11	13	tan clay			
13	16	yellow clay			
16	31	tan clay			
31	70	grey clay			
70	75	grey clay-gravel- $\frac{1}{2}$ pea			
75	98	grey/brown pea $\frac{1}{2}$ x $\frac{3}{4}$ chert-boulders			

7 CONTRACTOR'S OR LANDOWNER'S CERTIFICATION: This water well was (1) constructed, (2) reconstructed, or (3) plugged under my jurisdiction and was completed on (mo/day/year) **10-21-2002** and this record is true to the best of my knowledge and belief. Kansas Water Well Contractor's Licence No **182** This Water Well Record was completed on (mo/day/yr) **10-23-2002** under the business name of **Strader Drilling Co., Inc.** by (signature) *Dale Skren*