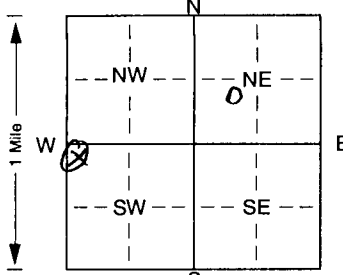


MW-170

1 LOCATION OF WATER WELL: Fraction NW NE SE NE SE Section Number 36 35 Township Number T 11 S Range Number R 23 E
 County: Wyandotte

Distance and direction from nearest town or city street address of well if located within city?
SE of N. 63rd + Trans

2 WATER WELL OWNER: Sonoco Packaging Group
 RR#, St. Address, Box #: 900 Blake Street Board of Agriculture, Division of Water Resources
 City, State, ZIP Code: Edwardsville, KS 66111 Application Number:

3 LOCATE WELL'S LOCATION WITH AN "X" IN SECTION BOX:

 4 DEPTH OF COMPLETED WELL: 65.0' ft. ELEVATION:
 Depth(s) Groundwater Encountered 1. ft. 2. ft. 3. ft.
 WELL'S STATIC WATER LEVEL 36.20 ft. below land surface measured on mo/day/yr 10-13-04
 Pump test data: Well water was ft. after hours pumping gpm
 Est. Yield gpm: Well water was ft. after hours pumping gpm
 Bore Hole Diameter: 3.25 in. to 65.0' ft., and in. to ft.
 WELL WATER TO BE USED AS: 5 Public water supply 8 Air conditioning 11 Injection well
 1 Domestic 3 Feedlot 6 Oil field water supply 9 Dewatering 12 Other (Specify below)
 2 Irrigation 4 Industrial 7 Domestic (lawn & garden) 10 Monitoring well
 Was a chemical/bacteriological sample submitted to Department? Yes. (No); If yes, mo/day/yr sample was submitted
 Water Well Disinfected? Yes (No)


5 TYPE OF CASING USED:
 1 Steel 3 RMP (SR) 5 Wrought iron 8 Concrete tile CASING JOINTS: Glued. Clamped.
2 PVC 4 ABS 6 Asbestos-Cement 9 Other (specify below) Welded
 Blank casing diameter One (1) " in. to 55' ft., Dia in. to ft., Dia in. to ft.
 Casing height above land surface 0-Flush in., weight lbs./ft. Wall thickness or gauge No. Sch. 40
 TYPE OF SCREEN OR PERFORATION MATERIAL:
 1 Steel 3 Stainless steel 5 Fiberglass 7 PVC 10 Asbestos-cement
 2 Brass 4 Galvanized steel 6 Concrete tile 8 RMP (SR) 11 Other (specify)
 9 ABS 12 None used (open hole)
 SCREEN OR PERFORATION OPENINGS ARE:
 1 Continuous slot 3 Mill slot 5 Gauzed wrapped 8 Saw cut 11 None (open hole)
 2 Louvered shutter 4 Key punched 6 Wire wrapped 9 Drilled holes
 7 Torch cut 10 Other (specify) ft.
 SCREEN-PERFORATED INTERVALS: From 55' ft. to 65' ft., From ft. to ft.
 From ft. to ft., From ft. to ft.
 GRAVEL PACK INTERVALS: From 53.0' ft. to 65.0' ft., From ft. to ft.
 From 21.0' ft. to 53.0' ft., From ft. to ft.

6 GROUT MATERIAL: 1 Neat cement 2 Cement grout 3 Bentonite 4 Other
 Grout Intervals: From 1' ft. to 2.1' ft., From ft. to ft., From ft. to ft.
 What is the nearest source of possible contamination:
 1 Septic tank 4 Lateral lines 7 Pit privy 10 Livestock pens 14 Abandoned water well
2 Sewer lines 5 Cess pool 8 Sewage lagoon 11 Fuel storage 15 Oil well/Gas well
 3 Watertight sewer lines 6 Seepage pit 9 Feedyard 12 Fertilizer storage 16 Other (specify below)
 13 Insecticide storage
 Direction from well? NW How many feet? 200-300'

FROM	TO	LITHOLOGIC LOG	FROM	TO	PLUGGING INTERVALS
0	8"	Asphalt			
8"	5'	Med Brown Clayey Silt			
5'	65'	Sandy Silt			

RECEIVED
 OCT 28 2004
 BUREAU OF WATER

7 CONTRACTOR'S OR LANDOWNER'S CERTIFICATION: This water well was (1) constructed, (2) reconstructed, or (3) plugged under my jurisdiction and was completed on (mo/day/year) 9-22-04 and this record is true to the best of my knowledge and belief. Kansas Water Well Contractor's Licence No. 606 This Water Well Record was completed on (mo/day/yr) 10-14-04 under the business name of PSA Environmental by (signature) [Signature]

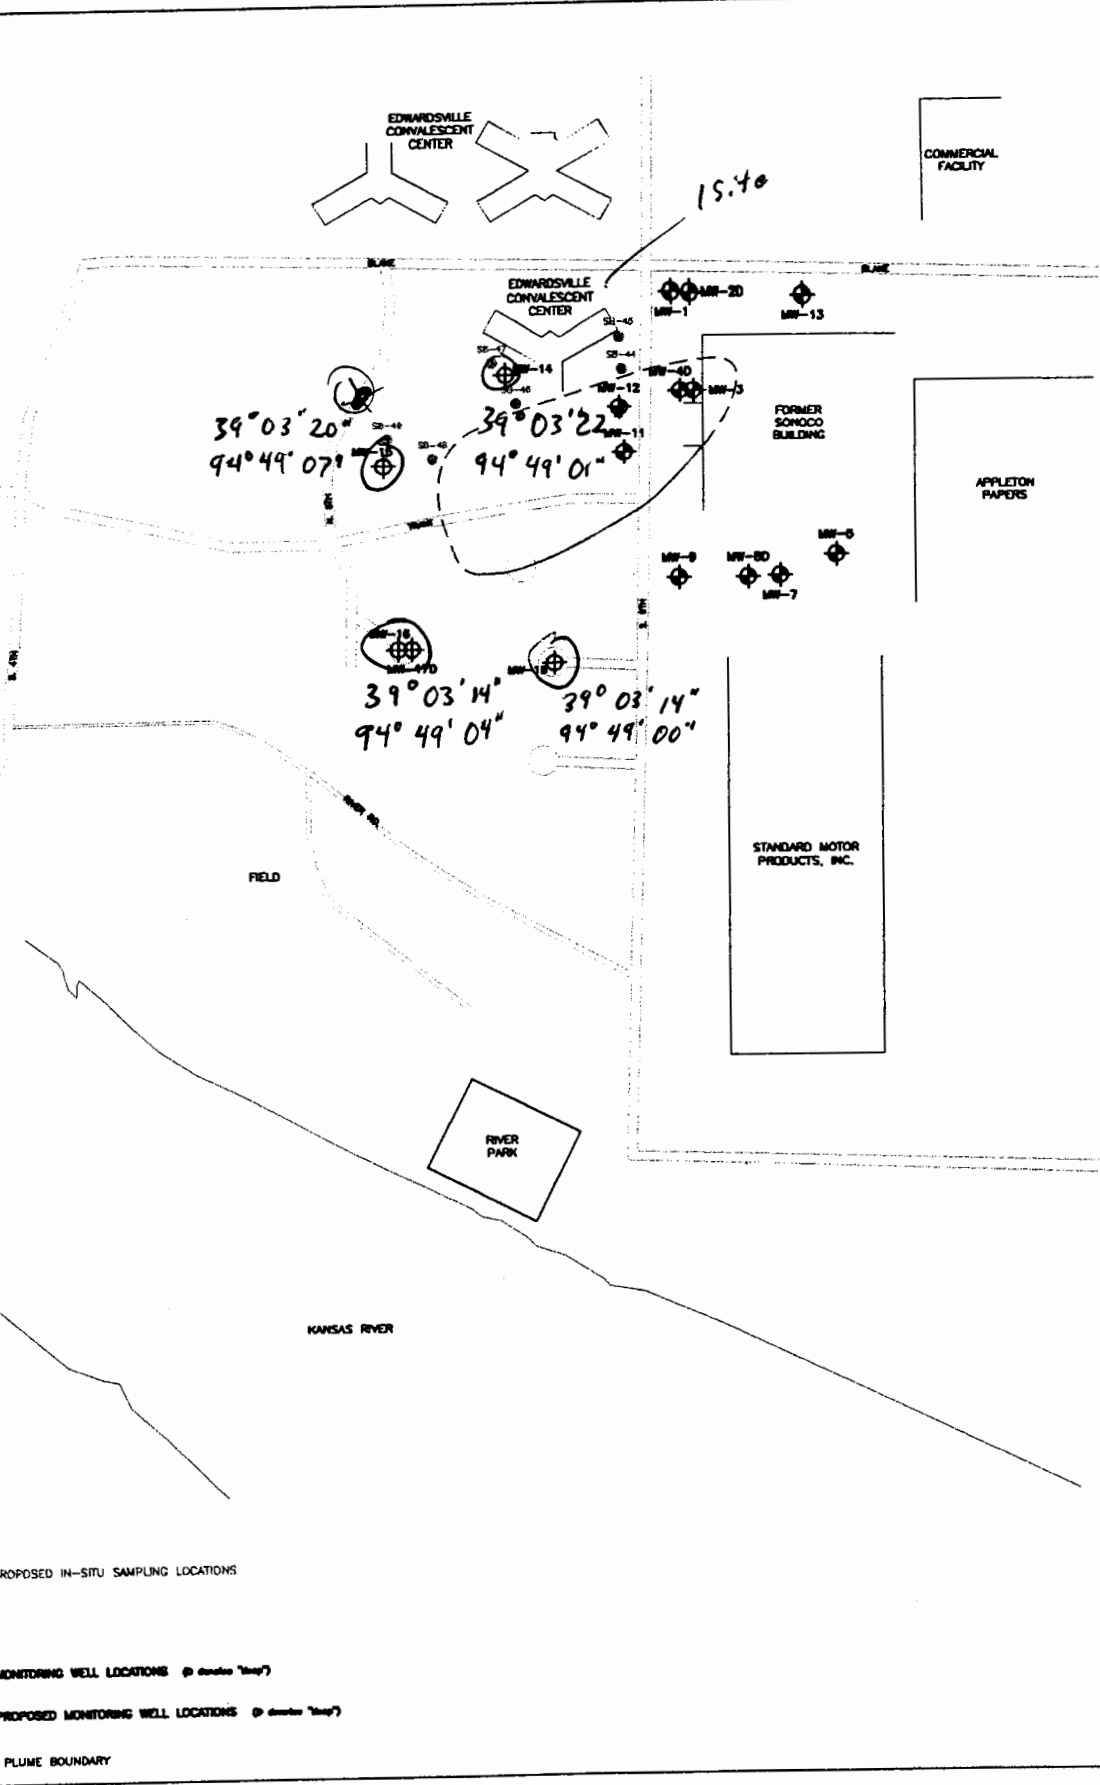

REVISION DESCRIPTION DATE	
revised (if)	8-30-04



Environmental Resources
 Management
 2920 South Willow Drive
 Suite 200
 Greenwood Village, Colorado 80111-5144
ERM (303) 741-0060

**SONOCO PACKAGING GROUP
 900 BLAKE STREET - EDWARDSVILLE, KANSAS 66111**

PROPOSED GROUND WATER MONITORING WELL LOCATIONS

MAY 2004

DESIGNED	MW/E
DRAWN	KJB
CHECKED	
DATE	
TIME	

FIGURE 1