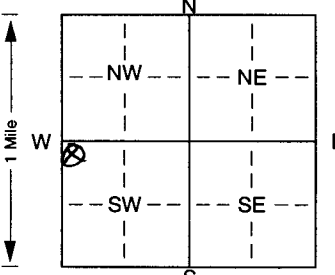


1] LOCATION OF WATER WELL: Fraction NE SW NE NE Section Number 346 35 Township Number T 11 S Range Number R 23 E
 County: Wyandotte

Distance and direction from nearest town or city street address of well if located within city?
SW of Blake & S. 9th Street

2] WATER WELL OWNER: Socoro Packaging Group
 RR#, St. Address, Box #: 400 Blake Street Board of Agriculture, Division of Water Resources
 City, State, ZIP Code: Edwardsville, KS 66111 Application Number:

3] LOCATE WELL'S LOCATION WITH AN "X" IN SECTION BOX:

 4] DEPTH OF COMPLETED WELL: 45.0 ft. ELEVATION:
 Depth(s) Groundwater Encountered 1. ft. 2. ft. 3. ft.
 WELL'S STATIC WATER LEVEL 34.53 ft. below land surface measured on mo/day/yr 10-13-04
 Pump test data: Well water was ft. after hours pumping gpm
 Est. Yield gpm: Well water was ft. after hours pumping gpm
 Bore Hole Diameter: 3.25 in. to 45.0 ft., and in. to ft.
 WELL WATER TO BE USED AS: 5 Public water supply 8 Air conditioning 11 Injection well
 1 Domestic 3 Feedlot 6 Oil field water supply 9 Dewatering 12 Other (Specify below)
 2 Irrigation 4 Industrial 7 Domestic (lawn & garden) 10 Monitoring well
 Was a chemical/bacteriological sample submitted to Department? Yes. No; If yes, mo/day/yr sample was submitted
 Water Well Disinfected? Yes No

5] TYPE OF BLANK CASING USED: 5 Wrought iron 8 Concrete tile CASING JOINTS: Glued. Clamped.
 1 Steel 3 RMP (SR) 6 Asbestos-Cement 9 Other (specify below) Welded
2 PVC 4 ABS 7 Fiberglass Threaded
 Blank casing diameter One (1) in. to 30 ft., Dia in. to ft., Dia in. to ft.
 Casing height above land surface: Flush in., weight lbs./ft. Wall thickness or gauge No. Sch. 40
 TYPE OF SCREEN OR PERFORATION MATERIAL: 7 PVC 10 Asbestos-cement
 1 Steel 3 Stainless steel 5 Fiberglass 8 RMP (SR) 11 Other (specify)
 2 Brass 4 Galvanized steel 6 Concrete tile 9 ABS 12 None used (open hole)
 SCREEN OR PERFORATION OPENINGS ARE: 5 Gauzed wrapped 8 Saw cut 11 None (open hole)
 1 Continuous slot 3 Mill slot 6 Wire wrapped 9 Drilled holes
 2 Louvered shutter 4 Key punched 7 Torch cut 10 Other (specify) ft.
 SCREEN-PERFORATED INTERVALS: From 30 ft. to 45 ft., From ft. to ft.
 GRAVEL PACK INTERVALS: From 2.8 ft. to 45 ft., From ft. to ft.
 From 1.9 ft. to 2.8 ft., From ft. to ft.

6] GROUT MATERIAL: 1 Neat cement 2 Cement grout 3 Bentonite 4 Other
 Grout Intervals: From 1 ft. to 19 ft., From ft. to ft., From ft. to ft.
 What is the nearest source of possible contamination:
 1 Septic tank 4 Lateral lines 7 Pit privy 10 Livestock pens 14 Abandoned water well
2 Sewer lines 5 Cess pool 8 Sewage lagoon 11 Fuel storage 15 Oil well/Gas well
 3 Watertight sewer lines 6 Seepage pit 9 Feedyard 12 Fertilizer storage 16 Other (specify below)
 13 Insecticide storage
 Direction from well? N & E How many feet?


FROM	TO	LITHOLOGIC LOG	FROM	TO	PLUGGING INTERVALS
0	6"	Asphalt			
6"	5'	Med. Brown Clayey Silt			
5'	10'	Sandy Silt			
10'	45'	Sandy Silt			

RECEIVED

OCT 28 2004

BUREAU OF WATER

7] CONTRACTOR'S OR LANDOWNER'S CERTIFICATION: This water well was (1) constructed, (2) reconstructed, or (3) plugged under my jurisdiction and was completed on (mo/day/year) 10-1-04 and this record is true to the best of my knowledge and belief. Kansas Water Well Contractor's Licence No. 606 This Water Well Record was completed on (mo/day/yr) 10-14-04 under the business name of PSA Environmental by (signature) [Signature]

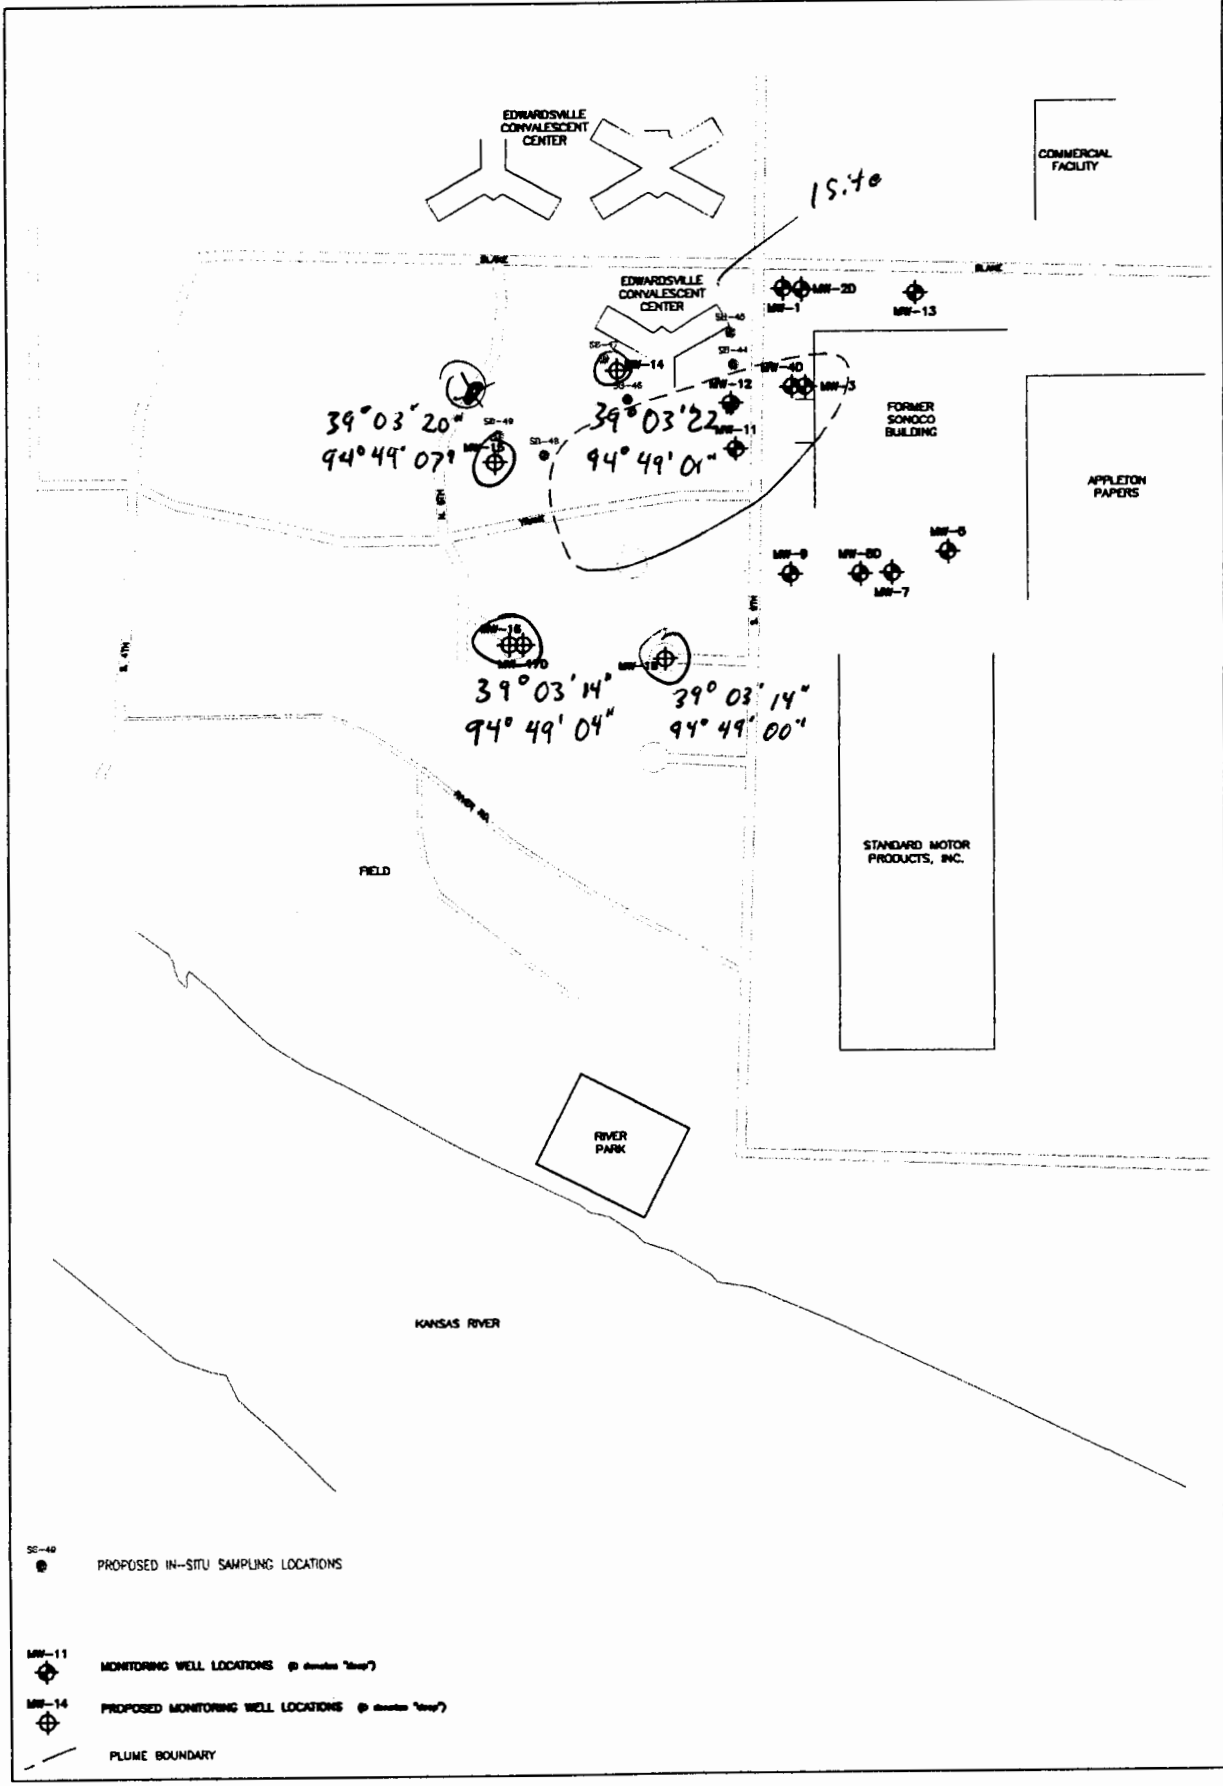

- SE-40
● PROPOSED IN-SITU SAMPLING LOCATIONS
- MW-11
⊕ MONITORING WELL LOCATIONS (⊕ denotes "stop")
- MW-14
⊕ PROPOSED MONITORING WELL LOCATIONS (⊕ denotes "stop")
- PLUME BOUNDARY

REVISION DESCRIPTION	DATE
revised (tbl)	6-30-04



Environmental Resources Management
 5900 North Willow Drive
 Suite 200
 Greenwood Village, Colorado 80111-6144
 (303) 741-8080

ERM

SONOCO PACKAGING GROUP
 900 BLAKE STREET - EDWARDSVILLE, KANSAS 66111

PROPOSED GROUND WATER MONITORING WELL LOCATIONS

MAY 2004

DESIGNED	MWE
DRAWN	EJE
CHECKED	
DATE	
TIME	

FIGURE **1**