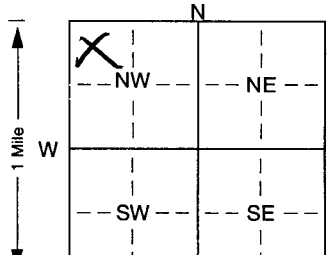


1 LOCATION OF WATER WELL:		Fraction	Section Number	Township Number	Range Number
County: <u>Wapahite</u>		<u>NW 1/4 NW 1/4 NW 1/4</u>	<u>36</u>	<u>11</u>	<u>S R 23</u> <u>EW</u>
Distance and direction from nearest town or city street address of well if located within city? <u>Southeast Corner Along 9th & Blake in Edwardsville, MS.</u>					
2 WATER WELL OWNER: <u>Sonoco Products Co</u>					
RR#, St. Address, Box # : <u>One North 2nd St</u>					
City, State, ZIP Code : <u>Hartsville, SC</u>					
Board of Agriculture, Division of Water Resources					
Application Number:					
3 LOCATE WELL'S LOCATION WITH		4 DEPTH OF COMPLETED WELL: <u>49</u> ft. ELEVATION:			
AN "X" IN SECTION BOX:		Depth(s) Groundwater Encountered 1. <u>38</u> ft. 2. ft. 3. ft.			
		WELL'S STATIC WATER LEVEL ft. below land surface measured on mo/day/yr			
		Pump test data: Well water was ft. after hours pumping gpm			
		Est. Yield gpm: Well water was ft. after hours pumping gpm			
		Bore Hole Diameter. in. to ft., and in. to ft.			
		WELL WATER TO BE USED AS: 5 Public water supply 8 Air conditioning 11 Injection well			
		1 Domestic 3 Feedlot 6 Oil field water supply 9 Dewatering 12 Other (Specify below)			
		2 Irrigation 4 Industrial 7 Domestic (lawn & garden) 10 Monitoring well <u>Remediation well</u>			
		<u>ART</u>			
		Was a chemical/bacteriological sample submitted to Department? Yes. <u>NO</u> ; If yes, mo/day/yr sample was submitted			
		Water Well Disinfected? Yes <u>NO</u>			
5 TYPE OF BLANK CASING USED:					
1 Steel 3 RMP (SR) 5 Wrought iron 8 Concrete tile CASING JOINTS: Glued. Clamped.					
2 <u>PVC</u> 4 ABS 6 Asbestos-Cement 9 Other (specify below) Welded					
7 Fiberglass Threaded.					
Blank casing diameter. 6" in. to 29' ft., Dia. in. to ft., Dia. in. to ft.					
Casing height above land surface. 1' in., weight Sch. 40 Flush End, lbs./ft. Wall thickness or gauge No.					
TYPE OF SCREEN OR PERFORATION MATERIAL:					
1 Steel 3 Stainless steel 5 Fiberglass 8 RMP (SR) 10 Asbestos-cement					
2 Brass 4 Galvanized steel 6 Concrete tile 9 ABS 11 Other (specify)					
12 None used (open hole)					
SCREEN OR PERFORATION OPENINGS ARE:					
1 Continuous slot 2 Louvered shutter 4 Key punched 5 Gauzed wrapped 8 Saw cut 11 None (open hole)					
6 Wire wrapped 9 Drilled holes					
7 Torch cut 10 Other (specify) ft.					
SCREEN-PERFORATED INTERVALS: From 29' ft. to 49' ft., From ft. to ft.					
From ft. to ft., From ft. to ft.					
GRAVEL PACK INTERVALS: From 26' ft. to 49' ft., From ft. to ft.					
From ft. to ft., From ft. to ft.					
6 GROUT MATERIAL: 1 Neat cement 2 Cement grout 3 Bentonite 4 Other <u>30% Solid Bent Grout</u>					
Grout Intervals: From 20.5' ft. to 22' ft., From chips 22' ft. to 26' ft., From ft. to ft.					
What is the nearest source of possible contamination:					
1 Septic tank 4 Lateral lines 7 Pit privy 10 Livestock pens 14 Abandoned water well					
2 Sewer lines 5 Cess pool 8 Sewage lagoon 11 Fuel storage 15 Oil well/Gas well					
3 Watertight sewer lines 6 Seepage pit 9 Feedyard 12 Fertilizer storage 16 Other (specify below)					
13 Insecticide storage					
Direction from well? How many feet?					
FROM TO LITHOLOGIC LOG FROM TO PLUGGING INTERVALS					
0 6' Brown Clay					
6 9' Brown silt					
9 14' Brn Sandy silt					
14 28' Brn silt & VF sand					
28 49' Brn Fine to Med Sand					
7 CONTRACTOR'S OR LANDOWNER'S CERTIFICATION: This water well was (1) constructed, (2) reconstructed, or (3) plugged under my jurisdiction and was completed on (mo/day/year) 4-04-06 and this record is true to the best of my knowledge and belief. Kansas Water Well Contractor's Licence No. This Water Well Record was completed on (mo/day/yr) 4-4-06 under the business name of HARRISS Drilling Services Inc. by (signature) Cecil J. Harris					
INSTRUCTIONS: Use typewriter or ball point pen. PLEASE PRESS FIRMLY & PRINT clearly. Please fill in blanks, underline or circle the correct answers. Send top three copies to Kansas Department of Health and Environment, Bureau of Water, Topeka, Kansas 66620-0001. Telephone 785-296-5524. Send one to WATER WELL OWNER and retain one for your records. Fee of \$5.00 for each constructed well.					