


1 LOCATION OF WATER WELL: County: **Wyandotte** Fraction: $\frac{1}{4}$ $\frac{1}{4}$ $\frac{1}{4}$ Section Number: **5** Township Number: **T 11 S** Range Number: **R 23 E/W**

Distance and direction from nearest town or city street address of well if located within city?
1601 130th Street, Kansas City, KS 66015 - Delaware Ridge Elementary School

2 WATER WELL OWNER: **Unified School District #204**
 RR#, St. Address, Box #: **2200 SO 138th St, PO Box 435** Board of Agriculture, Division of Water Resources
 City, State, ZIP Code: **Bonner Springs, KS 66012** Application Number:

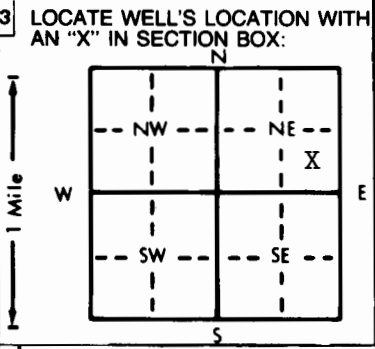

4 DEPTH OF COMPLETED WELL: ft. ELEVATION:
 Depth(s) Groundwater Encountered 1. ft. 2. ft. 3. ft.
 WELL'S STATIC WATER LEVEL ft. below land surface measured on mo/day/yr
 Pump test data: Well water was ft. after hours pumping gpm
 Est. Yield gpm: Well water was ft. after hours pumping gpm
 Bore Hole Diameter in. to ft., and in. to ft.
 WELL WATER TO BE USED AS:
 5 Public water supply Air conditioning 11 Injection well
 1 Domestic 3 Feedlot 6 Oil field water supply 9 Dewatering 12 Other (Specify below)
 2 Irrigation 4 Industrial 7 Lawn and garden only 10 Monitoring well
 Was a chemical/bacteriological sample submitted to Department? Yes.....No.....; If yes, mo/day/yr sample was submitted
 Water Well Disinfected? Yes No

5 TYPE OF BLANK CASING USED: None 5 Wrought iron 8 Concrete tile CASING JOINTS: Glued Clamped
 1 Steel 3 RMP (SR) 6 Asbestos-Cement 9 Other (specify below) Welded
 2 PVC 4 ABS 7 Fiberglass Threaded
 Blank casing diameter in. to ft., Dia in. to ft., Dia in. to ft.
 Casing height above land surface in., weight lbs./ft. Wall thickness or gauge No.
 TYPE OF SCREEN OR PERFORATION MATERIAL: None 7 PVC 10 Asbestos-cement
 1 Steel 3 Stainless steel 5 Fiberglass 8 RMP (SR) 11 Other (specify)
 2 Brass 4 Galvanized steel 6 Concrete tile 9 ABS 12 None used (open hole)
 SCREEN OR PERFORATION OPENINGS ARE: None 5 Gauzed wrapped 8 Saw cut 11 None (open hole)
 1 Continuous slot 3 Mill slot 6 Wire wrapped 9 Drilled holes
 2 Louvered shutter 4 Key punched 7 Torch cut 10 Other (specify)
 SCREEN-PERFORATED INTERVALS: From None ft. to ft., From ft. to ft.
 From ft. to ft., From ft. to ft.
 GRAVEL PACK INTERVALS: From ft. to ft., From ft. to ft.
 From ft. to ft., From ft. to ft.

6 GROUT MATERIAL: 1 Neat cement 2 Cement grout Bentonite 4 Other
 Grout Intervals: From 400 ft. to 10 ft., From ft. to ft., From ft. to ft.
 What is the nearest source of possible contamination:
 1 Septic tank 4 Lateral lines 7 Pit privy 10 Livestock pens 14 Abandoned water well
 2 Sewer lines 5 Cess pool 8 Sewage lagoon 11 Fuel storage 15 Oil well/Gas well
 Watertight sewer lines 6 Seepage pit 9 Feedyard 12 Fertilizer storage 16 Other (specify below)
 13 Insecticide storage
 Direction from well? How many feet?

FROM	TO	LITHOLOGIC LOG	FROM	TO	PLUGGING INTERVALS
0	3	Overburden	400	10	"Thermol grout Lite 88"
3	23	Clay			
23	50	Sandstone			
50	62	Shale			
62	73	Limestone			
73	146	Shale			
146	159	Limestone			
159	285	Shale			
285	342	Limestone			
342	400	Shale			

7 CONTRACTOR'S OR LANDOWNER'S CERTIFICATION: This water well was (1) constructed, (2) reconstructed, or (3) plugged under my jurisdiction and was completed on (mo/day/year) **October 27, 2006** and this record is true to the best of my knowledge and belief. Kansas Water Well Contractor's License No. **661** This Water Well Record was completed on (mo/day/yr) **Nov. 20, 2006** under the business name of **Ground Source Systems, Inc.** by (signature) *[Signature]*

OFFICE USE ONLY
T
R
EW
SEC.

County: Wyandotte Fraction: C Sec. 5 T. 11 S R. 23 E

CORRECTION(S) to WATER WELL COMPLETION RECORD Form WWC-5 (to rectify lacking or incorrect information)

Owner: Unified School District #204

If location corrected, was listed as:

Location changed to:

Section-Township-Range: _____

Fraction (1/4 calls): None Listed

C

Other changes: Initial statements: _____

No Longitude or Latitude listed

Changed to: _____

39.122364, -94.881424, NAD27

Comments: _____

Verification method: WWC5 Mapper

Initials: BK Date: 5-18-2021

Submitted by: Kansas Geological Survey, Data Resources Library, 1930 Constant Ave., Lawrence, KS 66047-3724
 Kansas Dept. of Health & Environment, Bureau of Water, 1000 SW Jackson, Suite 420, Topeka, KS 66612-1367