

WATER WELL RECORD

Form WWC-5


MW21

Division of Water Resources App. No.

1 LOCATION OF WATER WELL: County: Wyandotte, Fraction: NE 1/4 SE 1/4 SE 1/4 SW 1/4, Section Number: 6, Township No. T 11 S, Range Number R 23 E W

Street/Rural Address of Well Location; if unknown, distance & direction from nearest town or intersection: 13844 State Ave; Bonnel Springs, Ks. Global Positioning System (GPS) information: Latitude: 39.11906, Longitude: 94.90085, Elevation: 756.57

2 WATER WELL OWNER: JMK Partnership, RR#, Street Address, Box #: The Rully Company, City, State, ZIP Code: 608 Belair, Leavenworth, Ks. Collection Method: Land Survey

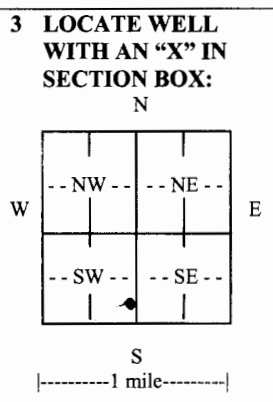

4 DEPTH OF COMPLETED WELL: 30' ft. Depth(s) Groundwater Encountered (1) 25' ft. WELL'S STATIC WATER LEVEL 28.91 ft. below land surface measured on mo/day/yr. Pump test data: Well water was... EST. YIELD... Bore Hole Diameter 7 1/8 in. to 30 ft. WELL WATER TO BE USED AS: Monitoring well

5 TYPE OF CASING USED: PVC, Threaded. CASING JOINTS: Threaded. Casing diameter 2.875 in. to 15 ft. Casing height above land surface Flush Mt. Weight... Wall thickness or gauge No. Sch 40

TYPE OF SCREEN OR PERFORATION MATERIAL: PVC. SCREEN OR PERFORATION OPENINGS ARE: Mill slot. SCREEN-PERFORATED INTERVALS: From 30' ft. to 15' ft. GRAVEL PACK INTERVALS: From 30' ft. to 13' ft.

6 GROUT MATERIAL: Bentonite, Concrete. Grout Intervals: From 12' ft. to 2' ft. What is the nearest source of possible contamination: Septic tank, Lateral lines, Pit privy, Livestock pens, Insecticide storage, Other (specify below)

Table with 6 columns: FROM, TO, LITHOLOGIC LOG, FROM, TO, LITHO. LOG (cont.) or PLUGGING INTERVALS. Rows describe soil layers from 0 to 30.0 feet depth.

7 CONTRACTOR'S OR LANDOWNER'S CERTIFICATION: This water well was constructed, reconstructed, or plugged under my jurisdiction and was completed on (mo/day/year) and this record is true to the best of my knowledge and belief. Kansas Water Well Contractor's License No. 732, This Water Well Record was completed on (mo/day/year) 12/10/12 under the business name of J.B. Environmental by (signature) James Biebu

INSTRUCTIONS: Use typewriter or ball point pen. PLEASE PRESS FIRMLY and PRINT clearly. Please fill in blanks and check the correct answers. Send three copies (white, blue, pink) to Kansas Department of Health and Environment, Bureau of Water, Geology Section, 1000 SW Jackson St., Suite 420, Topeka, Kansas 66612-1367. Telephone 785-296-5524. Send one copy to WATER WELL OWNER and retain one for your records. Include fee of \$5.00 for each constructed well. Visit us at http://www.kdheks.gov/waterwell/index.html.