

WATER WELL RECORD


Form WWC-5

Division of Water Resources App. No.

1 LOCATION OF WATER WELL: County: Wyandotte Fraction SE 1/4 SE 1/4 SE 1/4 SW 1/4 Section Number 6 Township No. T 11 S Range Number R 23 E W

Street/Rural Address of Well Location; if unknown, distance & direction from nearest town or intersection: 13844 State Ave; Bonnel Springs, Ks. Global Positioning System (GPS) information: Latitude: 39.11636 Longitude: 94.90035 Elevation: 972.93

2 WATER WELL OWNER: JMK Partnership RR#, Street Address, Box #: The Reilly Company City, State, ZIP Code: 608 Delaware Leavenworth, Ks. Collection Method: Land Survey Est. Accuracy: <3 m, 3-5 m, 5-15 m, >15 m

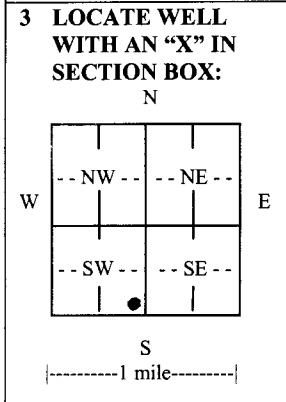

4 DEPTH OF COMPLETED WELL 30' ft. Depth(s) Groundwater Encountered (1) 24' ft. (2) ft. (3) ft. WELL'S STATIC WATER LEVEL 21.33 ft. below land surface measured on mo/day/yr Pump test data: Well water was ft. after hours pumping gpm EST. YIELD gpm Well water was ft. after hours pumping gpm Bore Hole Diameter 7 1/2 in. to 30 ft. and in. to in. to ft. WELL WATER TO BE USED AS: Monitoring well Was a chemical/bacteriological sample submitted to Department? No Water well disinfected? No

5 TYPE OF CASING USED: PVC CASING JOINTS: Threaded Casing diameter 2.375 in. to 15 ft. Casing height above land surface Flush ft. in. Weight lbs./ft. Wall thickness or gauge No Sch 40 TYPE OF SCREEN OR PERFORATION MATERIAL: PVC SCREEN OR PERFORATION OPENINGS ARE: Mill slot SCREEN-PERFORATED INTERVALS: From 30 ft. to 15 ft. GRAVEL PACK INTERVALS: From 30 ft. to 13 ft.

6 GROUT MATERIAL: Concrete Grout Intervals: From 13 ft. to 2 ft. What is the nearest source of possible contamination: Other (specify below) Direction from well Distance from well

Table with columns: FROM, TO, LITHOLOGIC LOG, FROM, TO, LITHO. LOG (cont.) or PLUGGING INTERVALS. Rows describe soil layers: 0-2' Bin sandy clay w/ gravel, 2-5' lt Bin well grained sand, 5-8' dk Bin sandy clay, 8-13' lt Red Bin weathered sandstone, 13-30' Red Bin sandstone, non stained.

7 CONTRACTOR'S OR LANDOWNER'S CERTIFICATION: This water well was constructed, reconstructed, or plugged under my jurisdiction and was completed on (mo/day/year) 11/19/12 and this record is true to the best of my knowledge and belief. Kansas Water Well Contractor's License No. 732 This Water Well Record was completed on (mo/day/year) 12/10/12 under the business name of JB Environmental by (signature) James Burk

INSTRUCTIONS: Use typewriter or ball point pen. PLEASE PRESS FIRMLY and PRINT clearly. Please fill in blanks and check the correct answers. Send three copies (white, blue, pink) to Kansas Department of Health and Environment, Bureau of Water, Geology Section, 1000 SW Jackson St., Suite 420, Topeka, Kansas 66612-1367. Telephone 785-296-5524. Send one copy to WATER WELL OWNER and retain one for your records. Include fee of \$5.00 for each constructed well. Visit us at http://www.kdheks.gov/waterwell/index.html.