

MW-1


WATER WELL PLUGGING RECORD Form WWC-5P KSA 82a-1212 ID NO.

Empty box for ID number

1 LOCATION OF WATER WELL: County: Wichita Fraction: SE 1/4 SE 1/4 SW 1/4 Section Number: 6 Township Number: 11 Range Number: 23 EAW

Distance and direction from nearest town or city street address of well if located within city? 13844 State Ave; Bonner Springs, KS.

2 WATER WELL OWNER: JHK Partnership The Reilly Company 608 Delaware Ravensworth, KS. Global Positioning Systems (decimal degrees, min. of 4 digits) Latitude: 39.11652 Longitude: 94.90050 Elevation: \_\_\_\_\_ Datum: \_\_\_\_\_ Data Collection Method: \_\_\_\_\_

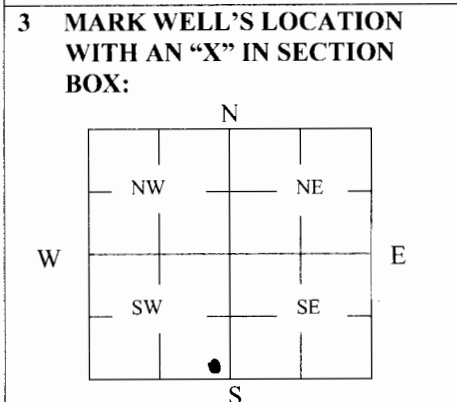

4 DEPTH OF WELL 25' ft. WELL'S STATIC WATER LEVEL Dry ft. WELL WAS USED AS: 1 Domestic 2 Irrigation 3 Feedlot 4 Industrial 5 Public Water Supply 6 Oil Field Water Supply 7 Domestic (Lawn & Garden) 8 Air Conditioning 9 Dewatering 10 Monitoring 11 Injection Well 12 Other \_\_\_\_\_ Was a chemical/bacteriological sample submitted to Department? Yes \_\_\_\_\_ No X

5 TYPE OF BLANK CASING USED: 1 Steel 2 PVC 3 RMP (SR) 4 ABS 5 Wrought 6 Asbestos-Cement 7 Fiberglass 8 Concrete Tile 9 Other (Specify below) \_\_\_\_\_ Blank casing diameter 2.375 in. Was casing pulled? Yes X No \_\_\_\_\_ If yes, how much 25' (all) Casing height above or below land surface \_\_\_\_\_ in.

6 GROUT PLUG MATERIAL: 1 Neat cement 2 Cement grout 3 Bentonite 4 Other Gravel Grout Plug Intervals: From 25' ft. to 1' ft., From 1' ft. to 0' ft., From \_\_\_\_\_ to \_\_\_\_\_ ft. What is the nearest source of possible contamination: 1 Septic tank 2 Sewer lines 3 Watertight sewer lines 4 Lateral lines 5 Cess pool 6 Seepage pit 7 Pit privy 8 Sewage lagoon 9 Feedyard 10 Livestock pens 11 Farmer Fuel Storage 12 Fertilizer storage 13 Insecticide storage 14 Abandoned water well 15 Oil well/Gas well 16 Other (specify below) In old Pit Area Direction from well: \_\_\_\_\_ How many feet? \_\_\_\_\_

Table with columns: FROM, TO, PLUGGING MATERIALS. Row 1: FROM, TO, Flush Mt. Manway was removed. Row 2: FROM, TO, 2" PVC pipe was plugged out (25'). Row 3: FROM, TO, Bentonite from 25'-1'. Row 4: FROM, TO, Gravel from 1'-0'.

7 CONTRACTOR'S OR LANDOWNER'S CERTIFICATION: This water well was plugged under my jurisdiction and was completed on (mo/day/year) 11/10/12 and this record is true to the best of my knowledge and belief. Kansas Water Well Contractor's License No. 732. This Water Well Record was completed on (mo/day/year) 12/10/12 under the business name of GB Environmental Drilling by (signature) James Becker

INSTRUCTIONS: Use typewriter or ballpoint pen. Please press firmly and print clearly. Please fill in blanks, underline or circle the correct answers. Send top three copies to Kansas Department of Health and Environment, Bureau of Water, Geology Section, 1000 SW Jackson St., Ste. 420, Topeka, Kansas 66612-1367. Telephone: 785/296-5522. Send one to Water Well Owner and retain one for your records. Visit us at http://www.kdheks.gov/geo/waterwells.