


1 LOCATION OF WATER WELL: County: Wyandotte Fraction SE 1/4 SE 1/4 SE 1/4 SW 1/4 Section Number 17 Township Number T 11 S Range Number 23 [X] E [] W

Street/Rural Address of Well Location; if unknown, distance & direction from nearest town or intersection: If at owner's address, check here [] Global Positioning Systems (GPS) information: Latitude: NA (in decimal degrees) Longitude: NA (in decimal degrees) Elevation: NA

13010 Kansas Ave., Bonner Springs, KS Horizontal Datum [] WGS84, [] NAD83, [] NAD27 Collection Method: [] GPS unit (Make/model: [] Digital Map/Photo, [] Topographic Map [] Land Survey

2 WATER WELL OWNER: Quality Markets RR#, St. Address, Box #: 210 W. 5th St. #409 City, State ZIP Code: Kansas City, MO 64105 Est. Accuracy: [] <3 m, [] 3-5 m, [] 5-15 m, [] >15 m

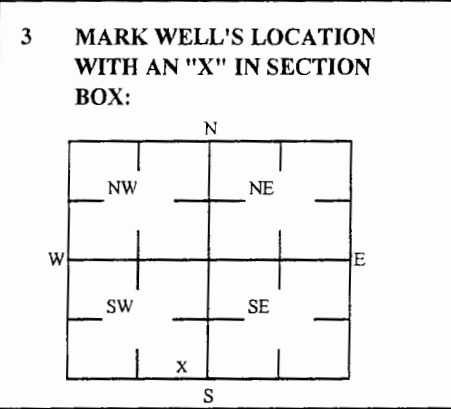

4 DEPTH OF WELL 14.5 ft. MW2 WELL'S STATIC WATER LEVEL _____ ft. WELL WAS USED AS: [] Domestic [] Irrigation [] Feedlot [] Industrial [] Public Water Supply [] Oil Field Water Supply [] Domestic (Lawn & Garden) [] Air Conditioning [] Dewatering [X] Monitoring [] Injection Well [] Other _____ Was a chemical/bacteriological sample submitted to Department? Yes [] No [X]

5 TYPE OF BLANK CASING USED: [] Steel [X] PVC [] RMP (SR) [] ABS [] Wrought [] Asbestos-Cement [] Fiberglass [] Concrete Tile [] Other (Specific below) Blank casing diameter 2 in. Casing height above or below land surface NA in. Was casing pulled? Yes [X] No [] If yes, how much 3'

6 GROUT PLUG MATERIAL: [] Neat cement [] Cement grout [X] Bentonite [X] Other Concrete: 0-0.5'; Soil: 0.5-3' Grout Plug Intervals: From 3 ft to 14.5 ft, From _____ ft to _____ ft, From _____ ft to _____ ft. What is the nearest source of possible contamination: [] Septic tank [] Sewer lines [] Watertight sewer lines [] Lateral lines [] Cess pool [] Seepage pit [] Pit privy [] Sewage lagoon [] Feed yard [] Livestock pens [X] Fuel storage [] Fertilizer storage [] Insecticide storage [] Abandoned water well [] Oil well/Gas well [] Other (specify below) _____ Direction from well? _____ How many feet? _____

Table with columns FROM, TO, PLUGGING MATERIALS. Rows: 0-0.5 Concrete, 0.5-3 Soil, 3-14.5 Bentonite. KDHE ID: Shop N Go: U4-105-00777

7 CONTRACTOR'S OR LANDOWNER'S CERTIFICATION: This water well was plugged under my jurisdiction and was completed on (mo/day/year) 1/27/16 and this record is true to the best of my knowledge and belief. Kansas Water Contractor's License No. 757. This Water Well Record was completed on (mo/day/year) 2/8/16 under the business name of Larsen & Associates, Inc. By (signature)

Send one white copy to Kansas Department of Health & Environment, Geology Section, 1000 SW Jackson Street, Ste. 420, Topeka, KS 66612-1367. Send one copy to WATER WELL OWNER and retain one for your records. Visit us at http://www.kdheks.gov/waterwell/index.html Telephone 785-296-5524.