

MW12R

1 LOCATION OF WATER WELL: County: Wyandotte Fraction: NE 1/4 NE 1/4 NE 1/4 NW 1/4 Section Number: 20 Township Number: T 11 S Range Number: 23 [X] E [ ] W


Street/Rural Address of Well Location; if unknown, distance & direction from nearest town or intersection: If at owner's address, check here [ ] -90' S of 13010 Kansas Ave.. Bonner Springs, KS

Global Positioning Systems (GPS) information: Latitude: NA (in decimal degrees) Longitude: NA (in decimal degrees) Elevation: NA

Horizontal Datum [ ] WGS84, [ ] NAD83, [ ] NAD27 Collection Method:

2 WATER WELL OWNER: Witkins, Rick RR#, St. Address, Box #: 210 W. 5th St. #409 City, State ZIP Code: Kansas City, MO 64105

[ ] GPS unit (Make/model: Digital Map/Photo, [ ] Topographic Map, [ ] Land Survey Est. Accuracy: [ ] <3 m, [ ] 3-5 m, [ ] 5-15 m, [ ] >15 m

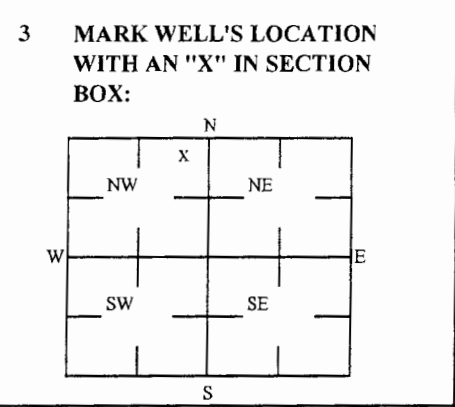

4 DEPTH OF WELL 18.1 ft. MW12R WELL'S STATIC WATER LEVEL ft. WELL WAS USED AS: [ ] Domestic, [ ] Irrigation, [ ] Feedlot, [ ] Industrial, [ ] Public Water Supply, [ ] Oil Field Water Supply, [ ] Domestic (Lawn & Garden), [ ] Air Conditioning, [ ] Dewatering, [X] Monitoring, [ ] Injection Well, [ ] Other. Was a chemical/bacteriological sample submitted to Department? Yes [ ] No [X]

5 TYPE OF BLANK CASING USED: [ ] Steel, [X] PVC, [ ] RMP (SR), [ ] ABS, [ ] Wrought, [ ] Asbestos-Cement, [ ] Fiberglass, [ ] Concrete Tile, [ ] Other (Specific below). Blank casing diameter 2 in. Was casing pulled? Yes [X] No [ ] If yes, how much 3' Casing height above or below land surface NA in.

6 GROUT PLUG MATERIAL: [ ] Neat cement, [ ] Cement grout, [X] Bentonite, [X] Other Concrete: 0-0.5'; Soil: 0.5-3'. Grout Plug Intervals: From 3 ft to 18.1 ft, From ft to ft, From ft to ft. What is the nearest source of possible contamination: [ ] Septic tank, [ ] Sewer lines, [ ] Watertight sewer lines, [ ] Lateral lines, [ ] Cess pool, [ ] Seepage pit, [ ] Pit privy, [ ] Sewage lagoon, [ ] Feed yard, [ ] Livestock pens, [X] Fuel storage, [ ] Fertilizer storage, [ ] Insecticide storage, [ ] Abandoned water well, [ ] Oil well/Gas well, [ ] Other (specify below). Direction from well? How many feet?

Table with 6 columns: FROM, TO, PLUGGING MATERIALS, FROM, TO, PLUGGING MATERIALS. Rows include 0-0.5 Concrete, 0.5-3 Soil, 3-18.1 Bentonite. KDHE ID: Shop N Go: U4-105-00777

7 CONTRACTOR'S OR LANDOWNER'S CERTIFICATION: This water well was plugged under my jurisdiction and was completed on (mo/day/year) 1/27/16 and this record is true to the best of my knowledge and belief. Kansas Water Contractor's License No. 757. This Water Well Record was completed on (mo/day/year) 2/8/16 under the business name of Larsen & Associates, Inc. By (signature)

Send one white copy to Kansas Department of Health & Environment, Geology Section, 1000 SW Jackson Street, Ste. 420, Topeka, KS 66612-1367. Send one copy to WATER WELL OWNER and retain one for your records. Visit us at http://www.kdheks.gov/waterwell/index.html Telephone 785-296-5524.