White—Driller's Copy 11-23-30 cd
Blue—Kansas Geological Survey
Pink—Customer Copy

BRT

WATER WELL RECORD Jack Rehm

DRILLERS LOG OF WELL

FROM (FT.)	TO (FT.)	KIND OF MATERIAL, COLOR, ETC. (NOTE WATER ZONES, AMOUNT, QUALITY)
0	6	Clay
6	21	Lime Broken
21	35	Shale
35	55	Lime
55	58	Shale
58	60	Slate WATER
60	65	Shale
65	80	Lime
80	90	Shale
90	110	Lime Mineral
		110 T. D.

Well Owner: Bob Lenahan

Address: Bonner Springs, Kansas

Drilling Contractor: Brauer Drilling Co. Basehor, Kansas

Date Drilled: 4/20/56

Method of Drilling: Cable Tools

Casing: Used Steel 15# Foot
(New, Used—Steel, Galv.—Gage or Weight)

Casing Schedule: 11½ft. 6¼
(Amount, Size, Setting)

Screen Data (if any):

ON COMPLETED WELL

Measured depth to water (Static Level) is 35 ft.

below Land Surface
(Land Surface, Top of Casing, Etc.)

TESTED YIELD: 1 gallons per min
(Min., Hour)

as determined by Est.
(Bailing, Test Pumping, Etc.)

DRAWDOWN: ft. after hrs.

pumping at gal. per minute.

REMARKS:

Good Well

Topeka Map shows dil house than Kleinschmidt's map on W.S. Both would be CDC But el for Well sched. loc = 800 (this entered)

LOCATION OF WELL

[Show location in Section Plat]

Elev. ~~1788~~ 800

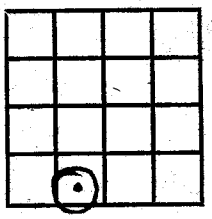

SW SE ¼ SW ¼ Sec. 30

T. 11 S., R. 23 E. W.

County Wyandotte

"To preserve water well information and to promote the conservation, protection, and development of ground-water resources."

26-1633-S—27-32 11-55-3M SETS

5-9-73
C 660

KANSAS WELL SCHEDULE

Card 1

Record by Kleinschmidt Date: 5-9-73 Project: top-KC State: Kan [1] County: ~~Trav~~ WYDT [2 3]

Latitude: deg min sec Longitude: deg min sec Accuracy: Owner's well no:

Location: ¼ ¼ SE ¼ SW no. sec. 30, T. 11 N., R. 23 E. Well number: [4 5 6 7 8 9 10 11 12 13 14]
S. W. T R E-W sec ¼ ¼ ¼ no.

Owner: Jack Rehm name 13938 Gibbs Bonner address

Owner: [15 16 17 18 19 20 21 22 23 24 25 26 27 28 29 30 31 32 33 34 35 36 37 38] Altitude: lsd [39 40 41 42 43] Accuracy [44]

Driller: name address Date drilled:

Topography, well site: (D) Draw, (F) flood plain, (L) lowland, (R) rolling, (S) slope, (T) terrace, (U) upland [45] Spring; or depth of well: 110 feet lsd [46 47 48 49] accuracy R [50]

Diameter: inches or feet [51 52] Depth cased: feet [53 54 55] Spring, or Csg. type: [56] Finish: [57] Lift & power: sub-elec [58]

Pump setting: lsd feet [59 60 61] Use of well: Domestic, stock, irrigation, industrial, public supply, observation, none, test C [62]

Water level: feet above below lsd [63 64 65] accuracy [66] date measured [67 68 69] mon year Water level records avail. [70]

Description MP: 2 or 3' Below Yard Behind House above below lsd

Yield: gpm [71 72 73 74] accuracy [75] Pumping period: hours or days [76 77] Specific capacity: gpm/ft. dd [78 79]

Pumpage and other data available: [80]

Card 2

Coefficient trans: gpd/ft [15 16 17] Coefficient storage: [18 19 20] Coefficient perm.: gpd/ft^2.

Aquifer, system or series [21] [22] [23] [24]

Aquifer, units [25 26 27] [28 29 30] [31 32 33]

[34 35 36] [37 38 39] [40 41 42] [43 44 45]

Aquifer, thickness: feet [46 47 48] Aquifer, length of well open to: feet [49 50 51] Aquifer, depth to top of: lsd feet [52 53 54] Aquifer, origin:

Aquifer, lithology of: [55 56]

Bedrock, system: [57] Bedrock, formation: [58 59 60] Bedrock, depth to: lsd feet [61 62 63]

Surficial material: lithology infiltration characteristics Log data avail: [64]

Quality of water data available: Salty Reported [65] Temperature of water: °F. [66 67] Date sampled: [68 69 70]

Coefficient of leakage.

Tarred Parkhill

THE FOLLOWING DATA ARE USED ON THE NATIONAL WELL SCHEDULE

Ownership category: (C) County, (F) Federal Gov't., (M) City, (N) Corp. or Co., (P) Private, (S) State Agency, (W) Water Dist. [71]

Method drilled: (A) Air, (B) bored, (C) cable, (D) dug, (V) driven, (H) hyd. rotary, (J) jetted, (R) rev. rotary, (T) trenching, (S) spring, [72]

Physiographic province: [73 74] Section:

Drainage basin: [75 76] Subbasin: Depth to basement: [77 78 79] source of data (basement) [80]

11-23-30 cd

Quadrangle

Well no. 11-23E-30 CD

Well no.

Well log

Geologic unit	Description of material	Thickness	Depth	Remarks

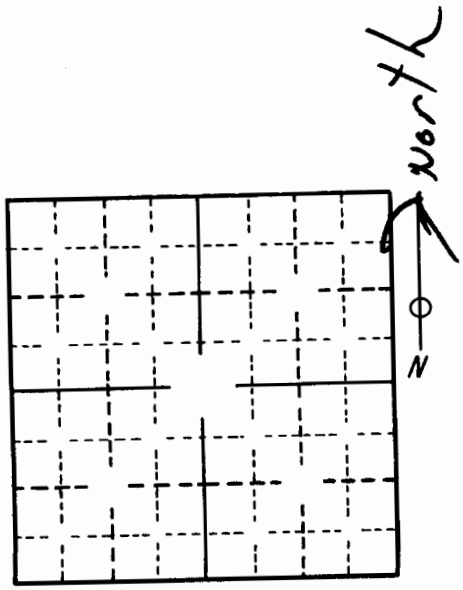

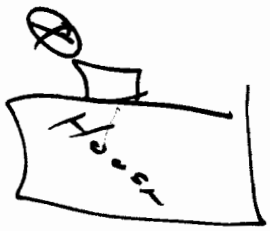

Deer

Creek

Watered Dogs & Pan
Turned White

37 Highway