


WATER WELL RECORD Form WWC-5 KSA 82a-1212

1 LOCATION OF WATER WELL: County: WYANDOTTE Fraction: SE 1/4 SE 1/4 SW 1/4 Section Number: 6 Township Number: T 11 S Range Number: R 23 E/W

Distance and direction from nearest town or city street address of well if located within city?
13844 STATE AVE BONNER SPRINGS

2 WATER WELL OWNER: JMK Partnership
 RR#, St. Address, Box #: PO Box 9
 City, State, ZIP Code: Leavenworth, Ks
 Board of Agriculture, Division of Water Resources
 Application Number:

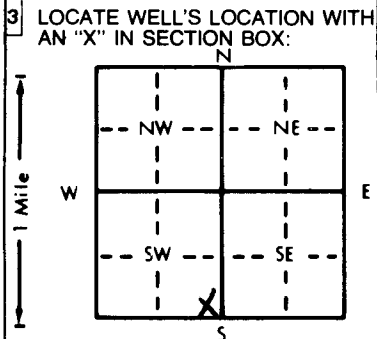

4 DEPTH OF COMPLETED WELL: 25 ft. ELEVATION: -
 Depth(s) Groundwater Encountered 1. 24 ft. 2. - ft. 3. - ft.
 WELL'S STATIC WATER LEVEL: 19.12 ft. below land surface measured on mo/day/yr 6-8-98
 Pump test data: Well water was - ft. after - hours pumping - gpm
 Est. Yield - gpm: Well water was - ft. after - hours pumping - gpm
 Bore Hole Diameter: 6 in. to 25 ft., and - in. to - ft.
 WELL WATER TO BE USED AS:
 5 Public water supply 8 Air conditioning 11 Injection well
 1 Domestic 3 Feedlot 6 Oil field water supply 9 Dewatering 12 Other (Specify below)
 2 Irrigation 4 Industrial 7 Lawn and garden only 10 Monitoring well MW 2
 Was a chemical/bacteriological sample submitted to Department? Yes - No ✓; If yes, mo/day/yr sample was submitted
 Water Well Disinfected? Yes - No ✓

5 TYPE OF BLANK CASING USED:
 1 Steel 3 RMP (SR) 5 Wrought iron 8 Concrete tile CASING JOINTS: Glued - Clamped -
2 PVC 4 ABS 6 Asbestos-Cement 9 Other (specify below) Welded -
 7 Fiberglass Threaded X
 Blank casing diameter 0 in. to 10 ft., Dia - in. to - ft., Dia - in. to - ft.
 Casing height above land surface: FLUSH in., weight - lbs./ft. Wall thickness or gauge No. SCH. 40
 TYPE OF SCREEN OR PERFORATION MATERIAL:
 1 Steel 3 Stainless steel 5 Fiberglass 8 RMP (SR) 10 Asbestos-cement
 2 Brass 4 Galvanized steel 6 Concrete tile 9 ABS 12 None used (open hole)
 SCREEN OR PERFORATION OPENINGS ARE:
 1 Continuous slot 3 Mill slot 5 Gauzed wrapped 8 Saw cut 11 None (open hole)
 2 Louvered shutter 4 Key punched 6 Wire wrapped 9 Drilled holes
 7 Torch cut 10 Other (specify) -
 SCREEN-PERFORATED INTERVALS: From 8.10 ft. to 25 ft., From - ft. to - ft.
 SAND GRAVEL PACK INTERVALS: From 8 ft. to 25 ft., From - ft. to - ft.

6 GROUT MATERIAL: 1 Neat cement 2 Cement grout 3 Bentonite 4 Other
 Grout Intervals: From 0 ft. to 6 ft., From 6 ft. to 8 ft., From - ft. to - ft.
 What is the nearest source of possible contamination:
 1 Septic tank 4 Lateral lines 7 Pit privy 10 Livestock pens 14 Abandoned water well
 2 Sewer lines 5 Cess pool 8 Sewage lagoon 11 Fuel storage 15 Oil well/Gas well
 3 Watertight sewer lines 6 Seepage pit 9 Feedyard 12 Fertilizer storage 16 Other (specify below)
CONTAMINATED SITE
 Direction from well? SITE How many feet? -

FROM	TO	LITHOLOGIC LOG	FROM	TO	PLUGGING INTERVALS
0	2'	SILT SAND AND GRAVEL FILL MATERIAL			
2'	3'	SILT, BROWN WITH FINE GRAINED SAND			
3'	9'	CLAY, DARK BROWN			
9'	11'	CLAY, BROWN			
11'	13'	FINE GRAINED SAND, BROWN			
13'	25'	WEATHERED SANDSTONE, BROWN			
25'	TD	END OF BOREHOLE			

7 CONTRACTOR'S OR LANDOWNER'S CERTIFICATION: This water well was (1) constructed, (2) reconstructed, or (3) plugged under my jurisdiction and was completed on (mo/day/year) 6-2-98 and this record is true to the best of my knowledge and belief. 

INSTRUCTIONS: Use typewriter or ball point pen. PLEASE PRESS FIRMLY and PRINT clearly. Please fill in blanks, underline or circle the correct answers. Send top three copies to Kansas Department of Health and Environment, Bureau of Water, Topeka, Kansas 66620-0001. Telephone: 913-296-5545. Send one to WATER WELL OWNER and retain one for your records.

OFFICE USE ONLY
T
R
EW
SEC.