


MW 3

WATER WELL RECORD Form WWC-5 KSA 82a-1212

1 LOCATION OF WATER WELL: County: **WYANDOTTE** Fraction: **SE 1/4 SE 1/4 SW 1/4** Section Number: **6** Township Number: **T 11 S** Range Number: **R 23 EW**

Distance and direction from nearest town or city street address of well if located within city?
13844 STATE AVE, BONNER SPRINGS

2 WATER WELL OWNER: **JMK Partnership** Board of Agriculture, Division of Water Resources
 RR#, St. Address, Box #: **PO Box 9** Application Number:
 City, State, ZIP Code: **Leavenworth, KS**

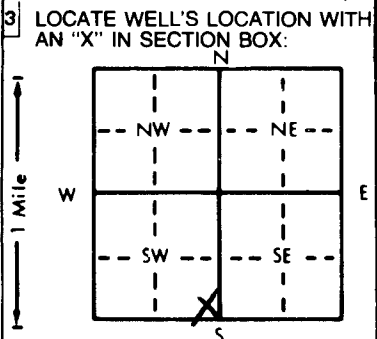

4 DEPTH OF COMPLETED WELL: **25** ft. ELEVATION: **-**
 Depth(s) Groundwater Encountered: 1. **21** ft. 2. **-** ft. 3. **-** ft.
 WELL'S STATIC WATER LEVEL: **18.62** ft. below land surface measured on mo/day/yr: **6-8-98**
 Pump test data: Well water was **-** ft. after **-** hours pumping **-** gpm
 Est. Yield **-** gpm: Well water was **-** ft. after **-** hours pumping **-** gpm
 Bore Hole Diameter: **6** in. to **25** ft., and **-** in. to **-** ft.
 WELL WATER TO BE USED AS:
 1 Domestic 3 Feedlot 6 Oil field water supply 9 Dewatering 12 Other (Specify below)
 2 Irrigation 4 Industrial 7 Lawn and garden only **10** Monitoring well **MW 3**
 Was a chemical/bacteriological sample submitted to Department? Yes **-** No **✓**; If yes, mo/day/yr sample was submitted
 Water Well Disinfected? Yes **-** No **✓**

5 TYPE OF BLANK CASING USED:
 1 Steel 3 RMP (SR) 6 Asbestos-Cement 9 Other (specify below)
 2 PVC 4 ABS 7 Fiberglass
 Blank casing diameter: **0** in. to **10** ft., Dia. **-** in. to **-** ft., Dia. **-** in. to **-** ft.
 Casing height above land surface: **FLUSH** in., weight **-** lbs./ft. Wall thickness or gauge No. **SCH 40**
 TYPE OF SCREEN OR PERFORATION MATERIAL:
 1 Steel 3 Stainless steel 5 Fiberglass 8 RMP (SR) 11 Other (specify)
 2 Brass 4 Galvanized steel 6 Concrete tile 9 ABS 12 None used (open hole)
 SCREEN OR PERFORATION OPENINGS ARE:
 1 Continuous slot 3 Mill slot 6 Wire wrapped 9 Drilled holes
 2 Louvered shutter 4 Key punched 7 Torch cut 10 Other (specify)
 SCREEN-PERFORATED INTERVALS: From **10** ft. to **25** ft., From **-** ft. to **-** ft., From **-** ft. to **-** ft.
 SAND ~~GRAVEL~~ PACK INTERVALS: From **8** ft. to **25** ft., From **-** ft. to **-** ft., From **-** ft. to **-** ft.

6 GROUT MATERIAL: 1 Neat cement 2 Cement grout 3 Bentonite 4 Other
 Grout Intervals: 2 From **0** ft. to **6** ft. 3 From **6** ft. to **8** ft. From **-** ft. to **-** ft.
 What is the nearest source of possible contamination:
 1 Septic tank 4 Lateral lines 7 Pit privy 10 Livestock pens 14 Abandoned water well
 2 Sewer lines 5 Cess pool 8 Sewage lagoon 11 Fuel storage 15 Oil well/Gas well
 3 Watertight sewer lines 6 Seepage pit 9 Feedyard 12 Fertilizer storage 16 Other (specify below) **CONTAMINATED SITE**
 13 Insecticide storage
 Direction from well? **How many feet?**

FROM	TO	LITHOLOGIC LOG	FROM	TO	PLUGGING INTERVALS
0	1'	SILT, SAND, GRAVEL FILL MATERIAL			
1'	2'	CLAY, BROWN			
2'	4'	CLAY, DARK BROWN			
4'	11'	FINE GRAINED SAND, BROWN			
11'	13'	SILT, BROWN WITH FINE GRAINED SAND			
13'	20'	FINE GRAINED SAND, BROWN			
20'	25'	WEATHERED SANDSTONE, BROWN			
25'	TD	END OF BOREHOLE			

7 CONTRACTOR'S OR LANDOWNER'S CERTIFICATION: This water well was **1** constructed, (2) reconstructed, or (3) plugged under my jurisdiction and was completed on (mo/day/year) **6-2-98** and this record is true to the best of my knowledge and belief, Kansas
 Water Well Contractor's License No. **-** This Water Well Record was completed on (mo/day/yr) **6-16-98**
 under the business name of **FLEEMAN DRILLING, LLC** by (signature) **David [Signature]**

INSTRUCTIONS: Use typewriter or ball point pen. PLEASE PRESS FIRMLY and PRINT clearly. Please fill in blanks, underline or circle the correct answers. Send top three copies to Kansas Department of Health and Environment, Bureau of Water, Topeka, Kansas 66620-0001. Telephone: 913-296-5545. Send one to WATER WELL OWNER and retain one for your records.

OFFICE USE ONLY
T
R
EW
SEC.
1/4
1/4
1/4