


mw 6

WATER WELL RECORD Form WWC-5 KSA 82a-1212

1 LOCATION OF WATER WELL: County: WYANDOTTE Fraction: SE 1/4 SE 1/4 SW 1/4 Section Number: 6 Township Number: T 11 S Range Number: R 23 E

Distance and direction from nearest town or city street address of well if located within city?  
13844 STATE AVE, BONNER SPRINGS

2 WATER WELL OWNER: JMK Partnership  
RR#, St. Address, Box #: PO Box 9 Board of Agriculture, Division of Water Resources  
City, State, ZIP Code: Leavenworth, KS Application Number:

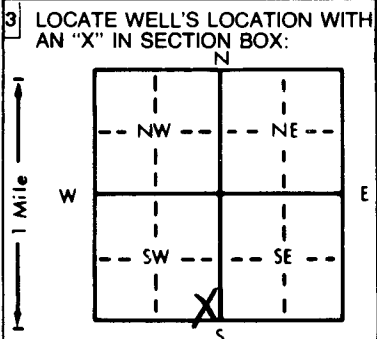

4 DEPTH OF COMPLETED WELL: 25 ft. ELEVATION: -  
Depth(s) Groundwater Encountered 1. 23 ft. 2. - ft. 3. - ft.  
WELL'S STATIC WATER LEVEL 21.29 ft. below land surface measured on mo/day/yr 6-8-98  
Pump test data: Well water was - ft. after - hours pumping - gpm  
Est. Yield - gpm: Well water was - ft. after - hours pumping - gpm  
Bore Hole Diameter: 6 in. to 25 ft., and - in. to - ft.  
WELL WATER TO BE USED AS:  
5 Public water supply 8 Air conditioning 11 Injection well  
1 Domestic 3 Feedlot 6 Oil field water supply 9 Dewatering 12 Other (Specify below)  
2 Irrigation 4 Industrial 7 Lawn and garden only 10 Monitoring well mw 6  
Was a chemical/bacteriological sample submitted to Department? Yes - No ✓ If yes, mo/day/yr sample was submitted  
Water Well Disinfected? Yes - No ✓

5 TYPE OF BLANK CASING USED:  
1 Steel 3 RMP (SR) 5 Wrought iron 8 Concrete tile CASING JOINTS: Glued - Clamped -  
2 PVC 4 ABS 6 Asbestos-Cement 9 Other (specify below) Welded -  
Blank casing diameter 0 in. to 15 ft., Dia - in. to - ft., Dia - in. to - ft.  
Casing height above land surface FLUSH in., weight - lbs./ft. Wall thickness or gauge No. SCH 40  
TYPE OF SCREEN OR PERFORATION MATERIAL:  
1 Steel 3 Stainless steel 5 Fiberglass 8 RMP (SR) 10 Asbestos-cement  
2 Brass 4 Galvanized steel 6 Concrete tile 9 ABS 12 None used (open hole)  
SCREEN OR PERFORATION OPENINGS ARE:  
1 Continuous slot 3 Mill slot 5 Gauzed wrapped 8 Saw cut 11 None (open hole)  
2 Louvered shutter 4 Key punched 6 Wire wrapped 9 Drilled holes  
3 Mill slot 7 Torch cut 10 Other (specify) -  
SCREEN-PERFORATED INTERVALS: From 15 ft. to 25 ft., From - ft. to - ft.  
SAND From - ft. to - ft., From - ft. to - ft.  
GRAVEL PACK INTERVALS: From 13 ft. to 25 ft., From - ft. to - ft.

6 GROUT MATERIAL: 1 Neat cement 2 Cement grout 3 Bentonite 4 Other  
Grout Intervals 2 From 0 ft. to 9 ft. 3 From 9 ft. to 13 ft. From - ft. to - ft.  
What is the nearest source of possible contamination:  
1 Septic tank 4 Lateral lines 7 Pit privy 10 Livestock pens 14 Abandoned water well  
2 Sewer lines 5 Cess pool 8 Sewage lagoon 11 Fuel storage 15 Oil well/Gas well  
3 Watertight sewer lines 6 Seepage pit 9 Feedyard 12 Fertilizer storage 16 Other (specify below) CONTAMINATED SITE  
13 Insecticide storage  
Direction from well? How many feet?

FROM	TO	LITHOLOGIC LOG	FROM	TO	PLUGGING INTERVALS
0	1'	SILT, SAND, GRAVEL FILL MATERIAL			
1'	8'	SILT, BROWN WITH FINE GRAINED SAND			
8'	10'	WEATHERED SANDSTONE, DARK BROWN			
10'	12'	WEATHERED SANDSTONE, BROWN			
12'	18'	FINE GRAINED SAND, BROWN			
18'	20'	WEATHERED SANDSTONE, BROWN			
20'	24'	FINE GRAINED SAND, BROWN			
24'	25'	SANDSTONE, BROWN			
25'	TO	END OF BOREHOLE			

7 CONTRACTOR'S OR LANDOWNER'S CERTIFICATION: This water well was 1 constructed, (2) reconstructed, or (3) plugged under my jurisdiction and was completed on (mo/day/year) 6-2-98 and this record is true to the best of my knowledge and belief. Kansas Water Well Contractor's License No. - This Water Well Record was completed on (mo/day/yr) 6-16-98 under the business name of FLEEMAX DRILLING, LLC by (signature) David [Signature]

INSTRUCTIONS: Use typewriter or ball point pen. PLEASE PRESS FIRMLY and PRINT clearly. Please fill in blanks, underline or circle the correct answers. Send top three copies to Kansas Department of Health and Environment, Bureau of Water, Topeka, Kansas 66620-0001. Telephone: 913-296-5545. Send one to WATER WELL OWNER and retain one for your records.

OFFICE USE ONLY  
T  
R  
EW  
SEC.  
1/4  
1/4  
1/4