


MW-11

1 LOCATION OF WATER WELL: Fraction NE 1/4 NE 1/4 NW 1/4 Section Number 7 Township Number T 11 S Range Number R 23 EW
 County: WYANDOTTE

Distance and direction from nearest town or city street address of well if located within city?
13844 State Ave Bonner Springs, Ks

2 WATER WELL OWNER: JMK Partnership
 RR#, St. Address, Box #: 13844 State Ave Board of Agriculture, Division of Water Resources
 City, State, ZIP Code: Bonner Springs, Ks Application Number:

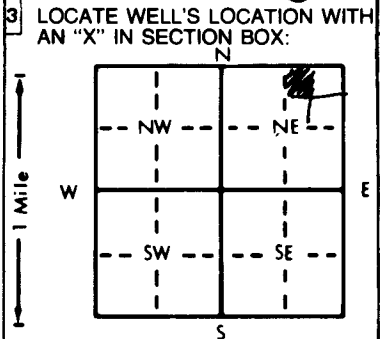

4 DEPTH OF COMPLETED WELL: 25 ft. ELEVATION: -
 Depth(s) Groundwater Encountered 1. 20 ft. 2. - ft. 3. - ft.
 WELL'S STATIC WATER LEVEL 13.85 ft. below land surface measured on mo/day/yr 8-19-98
 Pump test data: Well water was - ft. after - hours pumping - gpm
 Est. Yield - gpm; Well water was - ft. after - hours pumping - gpm
 Bore Hole Diameter 6" in. to 25 ft., and - in. to - ft.
 WELL WATER TO BE USED AS:
 5 Public water supply 8 Air conditioning 11 Injection well
 1 Domestic 3 Feedlot 6 Oil field water supply 9 Dewatering 12 Other (Specify below)
 2 Irrigation 4 Industrial 7 Lawn and garden only 10 Monitoring well
 Was a chemical/bacteriological sample submitted to Department? Yes - No 10; If yes, mo/day/yr sample was submitted
 Water Well Disinfected? Yes - No NA

5 TYPE OF BLANK CASING USED:
 1 Steel 3 RMP (SR) 5 Wrought iron 8 Concrete tile CASING JOINTS: Glued - Clamped -
2 PVC 4 ABS 6 Asbestos-Cement 9 Other (specify below) Welded - Threaded 11
 Blank casing diameter 2" in. to 15 ft., Dia - in. to - ft., Dia - in. to - ft.
 Casing height above land surface Flush in., weight 70 lbs./ft. Wall thickness or gauge No. Schedule 40
 TYPE OF SCREEN OR PERFORATION MATERIAL:
 1 Steel 3 Stainless steel 5 Fiberglass 8 RMP (SR) 10 Asbestos-cement
 2 Brass 4 Galvanized steel 6 Concrete tile 9 ABS 11 Other (specify) 12 None used (open hole)
 SCREEN OR PERFORATION OPENINGS ARE:
 1 Continuous slot 3 Mill slot 5 Gauzed wrapped 8 Saw cut 11 None (open hole)
 2 Louvered shutter 4 Key punched 7 Torch cut 9 Drilled holes
 SCREEN-PERFORATED INTERVALS: From 15 ft. to 25 ft., From - ft. to - ft.
 GRAVEL PACK INTERVALS: From 13 ft. to 25 ft., From - ft. to - ft.

6 GROUT MATERIAL: 1 Neat cement 2 Cement grout 3 Bentonite 4 Other
 Grout Intervals: 2 From 0 ft. to 9 ft., From 9 ft. to 13 ft., From - ft. to - ft.
 What is the nearest source of possible contamination:
 1 Septic tank 4 Lateral lines 7 Pit privy 11 Fuel storage 14 Abandoned water well
 2 Sewer lines 5 Cess pool 8 Sewage lagoon 12 Fertilizer storage 15 Oil well/Gas well
 3 Watertight sewer lines 6 Seepage pit 9 Feedyard 13 Insecticide storage 16 Other (specify below)

Direction from well? How many feet?

FROM	TO	LITHOLOGIC LOG	FROM	TO	PLUGGING INTERVALS
<u>0</u>	<u>8'</u>	<u>Clay fill Material</u>			
<u>8'</u>	<u>15'</u>	<u>Silt, Light Brown</u>			
<u>15'</u>	<u>25'</u>	<u>Silt, Brown with fine grained sand</u>			

7 CONTRACTOR'S OR LANDOWNER'S CERTIFICATION: This water well was 1 constructed, (2) reconstructed, or (3) plugged under my jurisdiction and was completed on (mo/day/year) 8-10-98 and this record is true to the best of my knowledge and belief. 

OFFICE USE ONLY
T
R
EW
SEC.
1/4
1/4
1/4