

WATER WELL RECORD Form WWC-5

Division of Water Resources App. No.

[]

Well ID

MW-6

Original Record Correction Change in Well Use

1 LOCATION OF WATER WELL: County: Wyandotte Fraction SW 1/4 SE 1/4 SE 1/4 Section Number 4 Township Number T 11 S Range Number R 23 E W

2 WELL OWNER: Last Name: City of Kansas City Kansas Address: 701 North 7th Street City: Kansas City State: KS ZIP: 66101 Street or Rural Address where well is located

3 LOCATE WELL WITH 'X' IN SECTION BOX: N W E S 1 mile 4 DEPTH OF COMPLETED WELL: 45 ft. 5 Latitude: 39.11750 Longitude: -94.63261

7 WELL WATER TO BE USED AS: 1. Domestic 2. Irrigation 3. Feedlot 4. Industrial 5. Public Water Supply 6. Dewatering 7. Aquifer Recharge 8. Monitoring MW-6 9. Environmental Remediation 10. Oil Field Water Supply 11. Test Hole 12. Geothermal 13. Other

Was a chemical/bacteriological sample submitted to KDHE? Water well disinfected?

8 TYPE OF CASING USED: Steel PVC Other CASING JOINTS: Glued Clamped Welded Threaded Casing diameter 2 in. to 45 ft. Diameter in. to ft. Casing height above land surface 0 in. Weight lbs./ft. Wall thickness or gauge No. Sch. 40

9 GROUT MATERIAL: Neat cement Cement grout Bentonite Other Concrete 0 to 2 feet Grout Intervals: From 2 ft. to ft., From ft. to ft., From ft. to ft.

Nearest source of possible contamination: Septic Tank Lateral Lines Pit Privy Livestock Pens Insecticide Storage Sewer Lines Cess Pool Sewage Lagoon Fuel Storage Abandoned Water Well Watertight Sewer Lines Seepage Pit Feedyard Fertilizer Storage Oil Well/Gas Well Other

Table with 6 columns: FROM, TO, LITHOLOGIC LOG, FROM, TO, LITHO. LOG (cont.) or PLUGGING INTERVALS. Includes Boring Logs attached and Notes section.

11 CONTRACTOR'S OR LANDOWNER'S CERTIFICATION: This water well was constructed, reconstructed, or plugged under my jurisdiction and was completed on (mo-day-year) 4-9-2021 and this record is true to the best of my knowledge and belief.

Mail 1 white copy along with a fee of \$5.00 for each constructed well to: Kansas Department of Health and Environment, Bureau of Water, GWTS Section, 1000 SW Jackson St., Suite 420, Topeka, Kansas 66612-1367. Mail one to Water Well Owner and retain one for your records. Telephone 785-296-5524.



- KC Housing Authority
- Property Boundary
- Monitoring Well
- Soil Boring
- Geotechnical Boring
- Current Building
- Former Tank Basin
- Commercial/Business District
- Residential
- Water
- Overhead Electric
- Gas
- Sewer


Notes:
 (1) Groundwater flow direction unknown, but inferred towards the southeast based on the location of the monitoring wells.
 (2) All ground utilities visible during the site visit are shown. Figures will be updated following the public and private utility locates conducted during the LSA.

METROPOLITAN EAST DISTRICT 1207 9TH S

CITY OF KANSAS CITY, MO 315 WASHINGTON BLVD


DESIGNED BY: CP
 DRAWN BY: CP
 CHECKED BY: JM
 APPROVED BY: CC
 DATE: FEBRUARY 2021

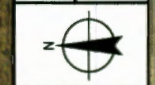

Site Map
 KC Housing Authority
 1124 North 9th St
 Kansas City, Kansas
 UA-105-15278

PPB
 environmental solutions

FIGURE 2
 Limited Site Assessment Work Plan


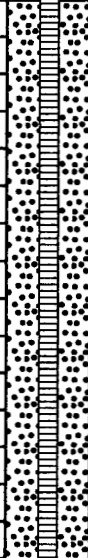
KSRBM INVESTMENTS, LLC
 650 STATE AVE

KWK'S PART, LLC
 650 STATE AVE

Project: **Kansas City Kansas Housing Authority**
 Project Location: **1125 North 9th Street, Kansas City, Kansas**
 Project Number: **U4-105-15278**

ppB enviro-solutions
 112 SW 6th Ave., Suite 201
 Topeka, Kansas
 785.256.0045

Log of Boring MW-6
Sheet 2 of 2

Elevation (feet)	Depth (feet)	Sample Type	Sample Number	PID Reading, ppm	Material Type	Graphic Log	MATERIAL DESCRIPTION	Well Log	REMARKS AND OTHER TESTS
829.77	30		30-32	0.3	CL		sandy clay; very moist		
824.77	35								
819.77	40								
814.77	45								
809.77	50								
804.77	55								
799.77	60								
794.77	65								