

WATER WELL RECORD Form WWC-5

Division of Water Resources App. No.


MW-7

Original Record Correction Change in Well Use

Well ID

1 LOCATION OF WATER WELL: County: Wyandotte Fraction SW 1/4 SE 1/4 SE 1/4 Section Number 4 Township Number T 11 S Range Number R 23 E W

2 WELL OWNER: Last Name: First: Street or Rural Address where well is located (if unknown, distance and direction from nearest town or intersection): If at owner's address, check here: City: Kansas City State: KS ZIP: 66101

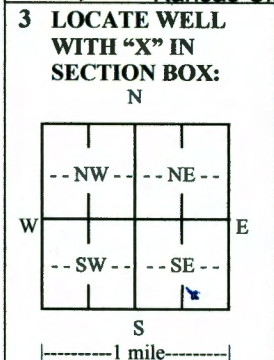

3 LOCATE WELL WITH 'X' IN SECTION BOX: N W E S 1 mile
4 DEPTH OF COMPLETED WELL: 55 ft. Depth(s) Groundwater Encountered: 1) 24.95 ft. 2) ft. 3) ft., or 4) Dry Well WEL'S STATIC WATER LEVEL: 24.95 ft. below land surface, measured on (mo-day-yr) 5-4-2021. above land surface, measured on (mo-day-yr) Pump test data: Well water was ft. after hours pumping gpm Well water was ft. after hours pumping gpm Estimated Yield: gpm Bore Hole Diameter: 8.25 in. to 55 ft. and in. to ft.

5 Latitude: 39.11711 (decimal degrees) Longitude: -94.63256 (decimal degrees) Horizontal Datum: WGS 84 NAD 83 NAD 27 Source for Latitude/Longitude: GPS (unit make/model): (WAAS enabled? Yes No) Land Survey Topographic Map Online Mapper
6 Elevation: 863.55 ft. Ground Level TOC Source: Land Survey GPS Topographic Map Other

7 WELL WATER TO BE USED AS: 1. Domestic: Household Lawn & Garden Livestock Irrigation Feedlot Industrial 5. Public Water Supply: well ID 6. Dewatering: how many wells? 7. Aquifer Recharge: well ID 8. Monitoring: well ID MW-7 9. Environmental Remediation: well ID Air Sparge Soil Vapor Extraction Recovery Injection 10. Oil Field Water Supply: lease 11. Test Hole: well ID Cased Uncased Geotechnical 12. Geothermal: how many bores? a) Closed Loop Horizontal Vertical b) Open Loop Surface Discharge Inj. of Water 13. Other (specify):

Was a chemical/bacteriological sample submitted to KDHE? Yes No If yes, date sample was submitted: Water well disinfected? Yes No

8 TYPE OF CASING USED: Steel PVC Other CASING JOINTS: Glued Clamped Welded Threaded Casing diameter 2 in. to 55 ft., Diameter in. to ft., Diameter in. to ft. Casing height above land surface 0 in. Weight lbs./ft. Wall thickness or gauge No. Sch. 40 TYPE OF SCREEN OR PERFORATION MATERIAL: Steel Stainless Steel Fiberglass PVC Other (Specify) Brass Galvanized Steel Concrete tile None used (open hole) SCREEN OR PERFORATION OPENINGS ARE: Continuous Slot Mill Slot Gauze Wrapped Torch Cut Drilled Holes Other (Specify) Louvered Shutter Key Punched Wire Wrapped Saw Cut None (Open Hole) SCREEN-PERFORATED INTERVALS: From 35 ft. to 55 ft., From ft. to ft., From ft. to ft. GRAVEL PACK INTERVALS: From 33 ft. to 55 ft., From ft. to ft., From ft. to ft.

9 GROUT MATERIAL: Neat cement Cement grout Bentonite Other Concrete 0 to 2 feet Grout Intervals: From 2 ft. to 33 ft., From ft. to ft., From ft. to ft. Nearest source of possible contamination: Septic Tank Lateral Lines Pit Privy Livestock Pens Insecticide Storage Sewer Lines Cess Pool Sewage Lagoon Fuel Storage Abandoned Water Well Watertight Sewer Lines Seepage Pit Feedyard Fertilizer Storage Oil Well/Gas Well Other (Specify) Direction from well? 0 Distance from well? Adjacent ft.

Table with 6 columns: FROM, TO, LITHOLOGIC LOG, FROM, TO, LITHO. LOG (cont.) or PLUGGING INTERVALS. Includes a Notes section.

11 CONTRACTOR'S OR LANDOWNER'S CERTIFICATION: This water well was constructed, reconstructed, or plugged under my jurisdiction and was completed on (mo-day-year) 4-7-2021 and this record is true to the best of my knowledge and belief. Kansas Water Well Contractor's License No. 759 This Water Well Record was completed on (mo-day-year) 6-6-2021 under the business name of RAZEK Environmental, LLC Signature



- KC Housing Authority
- Property Boundary
- Monitoring Well
- Soil Boring
- Geotechnical Boring
- Current Building
- Former Tank Basin
- Commercial/Business District
- Residential
- Water
- Overhead Electric
- Gas
- Sewer

**Notes:**  
 (1) Groundwater flow direction unknown, but inferred towards the southeast based on the location of the monitoring wells.  
 (2) All ground utilities visible during the site visit are shown. Figures will be updated following the public and private utility locates conducted during the LSA.


METROPOLITAN EAST DISTRICT  
 1207 9TH S

CITY OF KANSAS CITY, MO  
 315 WASHINGTON BLVD

UNIT STATES OF KANSAS  
 850 N.E. 8th St

DESIGNED BY: CP  
 DRAWN BY: CP  
 CHECKED BY: JM  
 APPROVED BY: CC  
 DATE: FEBRUARY 2021

Site Map  
 KC Housing Authority  
 1124 North 9th St  
 Kansas City, Kansas  
 UA-105-15278

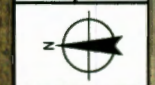

PPB  
 environmental solutions

**Limited Site Assessment Work Plan**  
**FIGURE 2**

KVKB PART LLC  
 650 STATE AVE

KVKB INVESTMENTS, LLC  
 650 STATE AVE














Project: Kansas City Kansas Housing Authority  
 Project Location: 1125 North 9th Street, Kansas City, Kansas  
 Project Number: U4-105-15278

ppB enviro-solutions  
 112 SW 6th Ave., Suite 201  
 Topeka, Kansas  
 785.256.0045

Log of Boring MW-7  
 Sheet 2 of 2

Elevation (feet)	Depth (feet)	Sample Type	Sample Number	PID Reading, ppm	Material Type	Graphic Log	MATERIAL DESCRIPTION	Well Log	REMARKS AND OTHER TESTS
833.91	30				CL		brown clay, plastic		
			30-32	0.3					
			33-35	0.2					
828.91	35								LAB
			35-37	0.3					
			38-40	0.2					
823.91	40								
			40-42	0.1					
			43-45	0.2					
818.91	45				CL		brown, sandy clay		LAB
813.91	50				SP		medium to coarse sand, brown		
808.91	55								
803.91	60								
798.91	65								

Macintosh HD:Users:janiemurphy\_OneDrive - ppB enviro-solutions:Documents:UST Projects:KC Housing Authority (#20024):LSA:Boring\_Logs:KC Boring\_Logs:bx4[PPB Well.tp]