USE TYPEWRITER OR BALL POINT PEN-PRESS FIRMLY, PRINT CLEARLY.

no #
no dot
Rw

WATER WELL RECORD
KSA 82a-1201-1215

Kansas Department of Health and Environment-Division of Environment
(Water well Contractors)
Topeka, Kansas 66620

1. Location of well:	County	Fraction	Section number	Township number	Range number
	Wyndotte	NW1/4 SW1/4 SW 1/4	15	T 11S S	R 23E EW

2. Distance and direction from nearest town or city:
Street address of well location if in city: 509 S. 118th St.KCK

3. Owner of well: Doyle Hackney
R.R. or street: 509 S.118th St.
City, state, zip code: Kansas City, Kansas

4. Locate with "X" in section below:

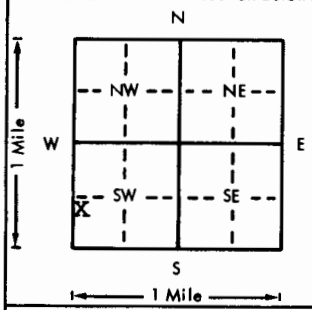

Sketch map:

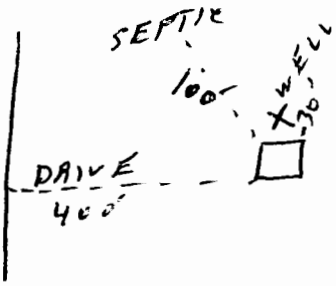

6. Bore hole dia. 8 1/4 in. Completion date ~~mo./day/yr.~~ 7-15-76
Well depth 125 ft.

7. X Cable tool ~~X~~ Rotary __ Driven __ Dug
__ Hallow rod __ Jetted __ Bored __ Reverse rotary

8. Use: X Domestic __ Public supply __ Industry
__ Irrigation __ Air conditioning __ Stock
__ Lawn __ Oil field water __ Other

9. Casing: Material _____ Height: Above or below
Threaded ____ Welded X Surface 12 in.
RMP ____ PVC X Weight 2 lbs./ft.
Dia. 6 in. to 125 ft. depth Wall Thickness: inches or
Dia. ____ in. to ____ ft. depth gage No. _____

10. Screen: Manufacturer's name _____
See Note
Type PVC Dia. _____
Slot/~~gauze~~ drill/slot Length _____
Set between 30 ft. and 125 ft.
_____ ft. and _____ ft.
Gravel pack? X Size range of material 1/4-1/8

11. Static water level: mo./day/yr.
30 ft. below land surface Date 7-15-76

12. Pumping level below land surfaces:
____ ft. after ____ hrs. pumping ____ g.p.m.
____ ft. after ____ hrs. pumping ____ g.p.m.
Estimated maximum yield 20GPH g.p.m.

13. Water sample submitted: mo./day/yr.
__ Yes XX No Date _____

14. Well head completion:
X Pitless adapter ____ Inches above grade

15. Well grouted? yes
With: X Neat cement ____ Bentonite ____ Concrete
Depth: From 5 ft. to 30 ft.

16. Nearest source of possible contamination:
ft. 100 Direction NW Type septic
Well disinfected upon completion? X Yes ____ No

17. Pump: ____ Not installed
Manufacturer's name Webtrol
Model number S0614MF3052 Volts 230
Length of drop pipe 115 ft. capacity 8 g.p.m.
Type:
X Submersible ____ Turbine
____ Jet ____ Reciprocating
____ Centrifugal ____ Other

5. Type and color of material

	From	To
surface (sandy.clay)yellow)	0	22
lime(grey)	22	38
shale(grey)	38	51
lime(lt.grey)	51	62
shale(dark)	62	67
lime(dark grey)	62	71
shale(grey)	71	91
lime(light grey)	91	101
shale(dark grey)	101	125
PVC DRILLED AND SLOTTED 30'-125'		
perforation size: 3/32		

(Use a second sheet if needed)

18. Elevation: 960 ~~95~~ ~~ft.~~
Topography:
X Hill
____ Slope
____ Upland
____ Valley

19. Remarks: Customer is aware of state regulation and agrees to install a 4' square re-enforced concrete platform around top of well.
X Doyle Hackney

20. Water well contractor's certification:
This well was drilled under my jurisdiction and this report is true to the best of my knowledge and belief.
F.E.Young Drilling 240
Business name License No.
Address 6355 Robinhood Ln.
Signed F.E. Young Date 9-76
Authorized representative

T 11 R 23 E Sec 15 1/4 NW 1/4 SW 1/4 SW

Forward the white, blue and pink copies to the Department of Health and Environment

Form WWC-5

MI-1023