


1 LOCATION OF WATER WELL: County: Wyandotte Fraction: SE 1/4 SE 1/4 SW 1/4 Section Number: 17 Township Number: T 11 S Range Number: R 23 EW

Distance and direction from nearest town or city street address of well if located within city?
Shop N 60 - 1/4 N of Bonner Spgs. Ks.

2 WATER WELL OWNER: Triple Net Assoc.
 RR#, St. Address, Box #: 3864 W. 75th. Board of Agriculture, Division of Water Resources
 City, State, ZIP Code: Prairie Village, Ks Application Number:

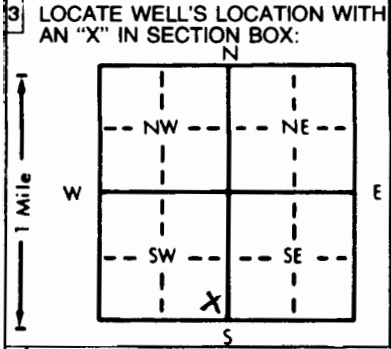

4 DEPTH OF COMPLETED WELL: 20 ft. ELEVATION: ft.
 Depth(s) Groundwater Encountered 1. 14 ft. 2. ft. 3. ft.
 WELL'S STATIC WATER LEVEL: 9.05 ft. below land surface measured on mo/day/yr 2/17/92
 Pump test data: Well water was ft. after hours pumping gpm
 Est. Yield gpm; Well water was ft. after hours pumping gpm
 Bore Hole Diameter: 6 5/8 in. to 20 ft., and in. to ft.
 WELL WATER TO BE USED AS: 5 Public water supply 8 Air conditioning 11 Injection well
 1 Domestic 3 Feedlot 6 Oil field water supply 9 Dewatering 12 Other (Specify below)
 2 Irrigation 4 Industrial 7 Lawn and garden only 10 Monitoring well
 Was a chemical/bacteriological sample submitted to Department? Yes..... No. X..... If yes, mo/day/yr sample was submitted
 Water Well Disinfected? Yes No

5 TYPE OF BLANK CASING USED: 1 Steel 3 RMP (SR) 5 Wrought iron 8 Concrete tile CASING JOINTS: Glued Clamped
2 PVC 4 ABS 6 Asbestos-Cement 9 Other (specify below) Welded
 Blank casing diameter: 2 1/4 in. to 10 ft., Dia. in. to ft., Dia. in. to ft.
 Casing height above land surface: Flush Height in., weight lbs./ft. Wall thickness or gauge No. SDR-13 Sch 40
 TYPE OF SCREEN OR PERFORATION MATERIAL: 7 PVC 10 Asbestos-cement
 1 Steel 3 Stainless steel 5 Fiberglass 8 RMP (SR) 11 Other (specify)
 2 Brass 4 Galvanized steel 6 Concrete tile 9 ABS 12 None used (open hole)
 SCREEN OR PERFORATION OPENINGS ARE: 5 Gauzed wrapped 8 Saw cut 11 None (open hole)
 1 Continuous slot 3 Mill slot .010 6 Wire wrapped 9 Drilled holes
 2 Louvered shutter 4 Key punched 7 Torch cut 10 Other (specify)
 SCREEN-PERFORATED INTERVALS: From 20 ft. to 10 ft., From ft. to ft.
 GRAVEL PACK INTERVALS: From 20 ft. to 8 ft., From ft. to ft.

6 GROUT MATERIAL: 1 Neat cement 2 Cement grout 3 Bentonite 4 Other
 Grout Intervals: From 8 ft. to 2 ft., From 2 ft. to 0 ft., From ft. to ft.
 What is the nearest source of possible contamination: 10 Livestock pens 14 Abandoned water well
 1 Septic tank 4 Lateral lines 7 Pit privy 11 Fuel storage 15 Oil well/Gas well
 2 Sewer lines 5 Cess pool 8 Sewage lagoon 12 Fertilizer storage 16 Other (specify below)
 3 Watertight sewer lines 6 Seepage pit 9 Feedyard 13 Insecticide storage
 Direction from well? North How many feet? 200

FROM	TO	LITHOLOGIC LOG	FROM	TO	PLUGGING INTERVALS
<u>0</u>	<u>12</u>	<u>Concrete</u>			
<u>12</u>	<u>15</u>	<u>lt. Brown to lt. Green silty clay w/ ls. & gravel, streaked</u>			
<u>15</u>	<u>20</u>	<u>lt. Brown-yellow weathered sandstone w/ fine gravel</u>			

7 CONTRACTOR'S OR LANDOWNER'S CERTIFICATION: This water well was (1 constructed, 2 reconstructed, or 3) plugged under my jurisdiction and was completed on (mo/day/year) 2/17/92 and this record is true to the best of my knowledge and belief. Kansas Water Well Contractor's License No. 539 This Water Well Record was completed on (mo/day/yr) 2/17/92 under the business name of JB Environmental Drilling by (signature) James Bieker

OFFICE USE ONLY
T
R
EW
SEC.
1/4
1/4
1/4