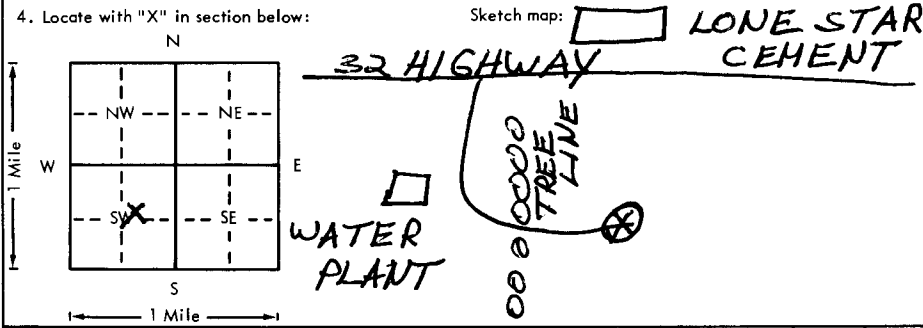


(Copy) PS

USE TYPEWRITER OR BALL POINT PEN-PRESS FIRMLY, PRINT CLEARLY.

WATER WELL RECORD
KSA 82a-1201-1215

Kansas Department of Health and Environment-Division of Environment
(Water well Contractors)
Topeka, Kansas 66620

1. Location of well:		County Wyandotte	Fraction SW 1/4 NE 1/4 SW 1/4	Section number 28	Township number T 12 S 11 R 23 E/W	Range number	
2. Distance and direction from nearest town or city: 1 mile East of Bonner Springs, Ks			3. Owner of well: City of Bonner Springs R.R. or street: 205 East 2nd Street City, state, zip code: Bonner Springs, Ks. 66012				
4. Locate with "X" in section below:		Sketch map: 		6. Bore hole dia. 18 in. Completion date 3-23-81 Well depth 79 ft.			
5. Type and color of material		From	To	7. Cable tool <input checked="" type="checkbox"/> Rotary <input type="checkbox"/> Driven <input type="checkbox"/> Dig <input type="checkbox"/> Hollow rod <input type="checkbox"/> Jetted <input type="checkbox"/> Bored <input type="checkbox"/> Reverse rotary			
Top Soil, Brown		0	3	8. Use: <input type="checkbox"/> Domestic <input checked="" type="checkbox"/> Public supply <input type="checkbox"/> Industry <input type="checkbox"/> Irrigation <input type="checkbox"/> Air conditioning <input type="checkbox"/> Stock <input type="checkbox"/> Lawn <input type="checkbox"/> Oil field water <input type="checkbox"/> Other			
Clay, Yellow Sandy		3	41	9. Casing: Material steel Height: Above or below Threaded <input type="checkbox"/> Welded <input checked="" type="checkbox"/> Surface 24 in. RMP <input type="checkbox"/> PVC <input type="checkbox"/> Weight 62.5 lbs./ft. Dia. 16 in. to 64 ft. depth Wall Thickness inches or Dia. <input type="checkbox"/> in. to <input type="checkbox"/> ft. depth Gage No. 375			
Sand, Fine		41	45	10. Screen: Manufacturer's name Johnson Type 304 stainless 16" Slot/gauze 150 Length 15 Set between 84 ft. and 79 ft. _____ ft. and _____ ft. Gravel pack? No Size range of material _____			
Sand, Yellow Medium to Coarse		45	56	11. Static water level: _____ ma./day/yr. 51 ft. below land surface Date 1-20-81			
Wooden Log		56	57	12. Pumping level below land surfaces: 68 ft. after 1 hrs. pumping 1000 g.p.m. _____ ft. after _____ hrs. pumping _____ g.p.m. Estimated maximum yield 1400 g.p.m.			
Sand, Medium to Coarse		57	72	13. Water sample submitted: _____ ma./day/yr. <input type="checkbox"/> Yes <input checked="" type="checkbox"/> No Date _____			
Sand and Gravel Coarse to very Coarse		72	79	14. Well head completion: <input checked="" type="checkbox"/> Pitless adapter 24 Inches above grade			
(Use a second sheet if needed)				15. Well grouted? <input checked="" type="checkbox"/> With: <input type="checkbox"/> Neat cement <input type="checkbox"/> Bentonite <input checked="" type="checkbox"/> Concrete Depth: From 24 ft. to 4 ft.			
18. Elevation: 800'		19. Remarks:		16. Nearest source of possible contamination: ft. 200 Direction South Type River Well disinfected upon completion? <input checked="" type="checkbox"/> Yes <input type="checkbox"/> No			
Topography: cut, 765' <input type="checkbox"/> Hill <input type="checkbox"/> Slope <input type="checkbox"/> Upland <input checked="" type="checkbox"/> Valley				17. Pump: Manufacturer's name Byron-Jackson <input type="checkbox"/> Not installed Model number MG 460 HP 125 Volts 460 Length of drop pipe 57'6" ft. capacity 1000 g.p.m. Type: <input checked="" type="checkbox"/> Submersible <input type="checkbox"/> Turbine <input type="checkbox"/> Jet <input type="checkbox"/> Reciprocating <input type="checkbox"/> Centrifugal <input type="checkbox"/> Other			
				20. Water well contractor's certification: This well was drilled under my jurisdiction and this report is true to the best of my knowledge and belief. F.E. Young Drilling 2400 Business name License No. Address 6355 Robin Hood Merriam Signed David Young Date 4-30-81 Authorized representative			

12 23 28
T
R
W
Sec
1/4 1/4 1/4

Forward the white, blue and pink copies to the Department of Health and Environment

Form WWC-5