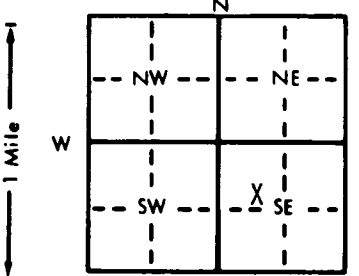


1 LOCATION OF WATER WELL: Fraction SW 1/4 NW 1/4 SE 1/4 Section Number 28 Township Number T 11 S Range Number R 23 EW

Distance and direction from nearest town or city street address of well if located within city?
50' West of 11565 K-32 Hwy., Bonner Springs, Kansas

2 WATER WELL OWNER: Safety-Kleen
RR#, St. Address, Box #: 777 Big Timber Rd. Board of Agriculture, Division of Water Resources
City, State, ZIP Code: Elgin, Illinois 60123 Application Number:

3 LOCATE WELL'S LOCATION WITH AN "X" IN SECTION BOX:  4 DEPTH OF COMPLETED WELL... 45.0 ft. ELEVATION:
Depth(s) Groundwater Encountered 1... 41 ft. 2... ft. 3... ft.
WELL'S STATIC WATER LEVEL... 41 ft. below land surface measured on mo/day/yr 10/10/89
Pump test data: Well water was ... ft. after ... hours pumping ... gpm
Est. Yield ... gpm: Well water was ... ft. after ... hours pumping ... gpm
Bore Hole Diameter... 10 in. to 45.0 ft., and ... in. to ... ft.
WELL WATER TO BE USED AS: 5 Public water supply 8 Air conditioning 11 Injection well
1 Domestic 3 Feedlot 6 Oil field water supply 9 Dewatering 12 Other (Specify below)
2 Irrigation 4 Industrial 7 Lawn and garden only 10 Observation well
Was a chemical/bacteriological sample submitted to Department? Yes... No... X...; If yes, mo/day/yr sample was submitted
Water Well Disinfected? Yes No X

5 TYPE OF BLANK CASING USED: 5 Wrought iron 8 Concrete tile CASING JOINTS: Glued ... Clamped ...
1 Steel 3 RMP (SR) 6 Asbestos-Cement 9 Other (specify below) Welded ...
2 PVC 4 ABS 30 Fiberglass Threaded... X
Blank casing diameter ... in. to ... ft., Dia ... in. to ... ft., Dia ... in. to ... ft.
Casing height above land surface... 30 in., weight Sch. 40 lbs./ft. Wall thickness or gauge No.
TYPE OF SCREEN OR PERFORATION MATERIAL: 7 PVC 10 Asbestos-cement
1 Steel 3 Stainless steel 5 Fiberglass 8 RMP (SR) 11 Other (specify) ...
2 Brass 4 Galvanized steel 6 Concrete tile 9 ABS 12 None used (open hole)
SCREEN OR PERFORATION OPENINGS ARE: 5 Gauzed wrapped 8 Saw cut 11 None (open hole)
1 Continuous slot 3 Mill slot 6 Wire wrapped 9 Drilled holes
2 Louvered shutter 4 Key punched 7 Torch cut 10 Other (specify) ...
SCREEN-PERFORATED INTERVALS: From ... 45.0 ft. to ... 30.0 ft., From ... ft. to ... ft.
GRAVEL PACK INTERVALS: From ... 45.0 ft. to ... 28.0 ft., From ... ft. to ... ft.

6 GROUT MATERIAL: 1 Neat cement 2 Cement grout 3 Bentonite 4 Other ...
Grout Intervals: From ... 0 ft. to ... 26.0 ft., From ... 26.0 ft. to ... 28.0 ft., From ... ft. to ... ft.
What is the nearest source of possible contamination: 10 Livestock pens 14 Abandoned water well
1 Septic tank 4 Lateral lines 7 Pit privy 11 Fuel storage 15 Oil well/Gas well
2 Sewer lines 5 Cess pool 8 Sewage lagoon 12 Fertilizer storage 16 Other (specify below)
3 Watertight sewer lines 6 Seepage pit 9 Feedyard 13 Insecticide storage Solvent Plant.
Direction from well? East How many feet? 50'

FROM	TO	LITHOLOGIC LOG	FROM	TO	LITHOLOGIC LOG
0	13.0	Brown Sandy Silt			
13.0	28.0	Dark Gray Clay			
28.0	45.0	Brown Medium to Coarse Sand			
		8" Steel Casing Set			

7 CONTRACTOR'S OR LANDOWNER'S CERTIFICATION: This water well was (1) constructed, (2) reconstructed, or (3) plugged under my jurisdiction and was completed on (mo/day/year) 10/10/89 and this record is true to the best of my knowledge and belief. Kansas
Water Well Contractor's License No. 416 This Water Well Record was completed on (mo/day/yr) 11/28/89
under the business name of Terracon Consultants SE, Inc. by (signature) *Edward M. Keets*

INSTRUCTIONS: Use typewriter or ball point pen. PLEASE PRESS FIRMLY and PRINT clearly. Please fill in blanks, underline or circle the correct answers. Send top three copies to Kansas Department of Health and Environment, Office of Oil Field and Environmental Geology, Regulation and Permitting Section, Topeka, Kansas 66620-7500, Telephone: 913-862-9360. Send one to WATER WELL OWNER and retain one for your records.