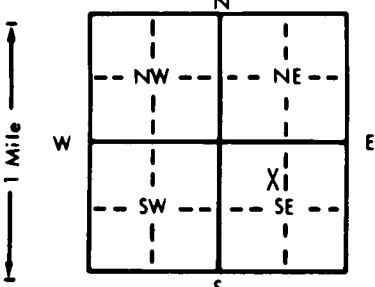


1 LOCATION OF WATER WELL: County: Wyandotte Fraction: SW $\frac{1}{4}$ NW $\frac{1}{4}$ SE $\frac{1}{4}$ Section Number: 28 Township Number: T 11 S Range Number: R 23 **EW**

Distance and direction from nearest town or city street address of well if located within city?
50' west of 11565 K-32 Hwy., Bonner Springs, Kansas

2 WATER WELL OWNER: Safety-Kleen
 RR#, St. Address, Box #: 777 Big Timber Rd.
 City, State, ZIP Code: Elgin, Illinois 60123
 Board of Agriculture, Division of Water Resources
 Application Number:

3 LOCATE WELL'S LOCATION WITH AN "X" IN SECTION BOX:

 4 DEPTH OF COMPLETED WELL: 45.0 ft. ELEVATION:
 Depth(s) Groundwater Encountered: 1. 42.0 ft. 2. ft. 3. ft.
 WELL'S STATIC WATER LEVEL: 42.0 ft. below land surface measured on mo/day/yr 10/12/89
 Pump test data: Well water was ft. after hours pumping gpm
 Est. Yield gpm: Well water was ft. after hours pumping gpm
 Bore Hole Diameter: 10 in. to 45.0 ft., and in. to ft.
 WELL WATER TO BE USED AS: 5 Public water supply 8 Air conditioning 11 Injection well
 1 Domestic 3 Feedlot 6 Oil field water supply 9 Dewatering 12 Other (Specify below)
 2 Irrigation 4 Industrial 7 Lawn and garden only **10** Observation well
 Was a chemical/bacteriological sample submitted to Department? Yes.....No **X**; If yes, mo/day/yr sample was submitted
 Water Well Disinfected? Yes No **X**

5 TYPE OF BLANK CASING USED:
 1 Steel 3 RMP (SR) 5 Wrought iron 8 Concrete tile CASING JOINTS: Glued Clamped
2 PVC 4 ABS 7 Fiberglass 9 Other (specify below) Welded Threaded **X**
 Blank casing diameter: 4 in. to 30.0 ft., Dia. in. to ft., Dia. in. to ft.
 Casing height above land surface: 0 in., weight Sch. 40 lbs./ft. Wall thickness or gauge No.
 TYPE OF SCREEN OR PERFORATION MATERIAL:
 1 Steel **3** Stainless steel 5 Fiberglass 8 RMP (SR) 10 Asbestos-cement
 2 Brass 4 Galvanized steel 6 Concrete tile 9 ABS 11 Other (specify)
 12 None used (open hole)
 SCREEN OR PERFORATION OPENINGS ARE:
1 Continuous slot 3 Mill slot 5 Gauzed wrapped 8 Saw cut 11 None (open hole)
 2 Louvered shutter 4 Key punched 6 Wire wrapped 9 Drilled holes
 7 Torch cut 10 Other (specify)
 SCREEN-PERFORATED INTERVALS: From 45.0 ft. to 30.0 ft., From ft. to ft.
 GRAVEL PACK INTERVALS: From 45.0 ft. to 28.0 ft., From ft. to ft.

6 GROUT MATERIAL: **1** Neat cement 2 Cement grout **3** Bentonite 4 Other
 Grout intervals: From 0 ft. to 26.0 ft., From 26.0 ft. to 28.0 ft., From ft. to ft.
 What is the nearest source of possible contamination:
 1 Septic tank 4 Lateral lines 7 Pit privy 10 Livestock pens 14 Abandoned water well
 2 Sewer lines 5 Cess pool 8 Sewage lagoon 11 Fuel storage 15 Oil well/Gas well
 3 Watertight sewer lines 6 Seepage pit 9 Feedyard 12 Fertilizer storage 16 Other (specify below)
 Solvent Plant
 Direction from well? East How many feet? 50'

FROM	TO	LITHOLOGIC LOG	FROM	TO	LITHOLOGIC LOG
0	.4	Concrete			
.4	14.5	Brown Silty Sand & Clay			
14.5	24.5	Gray Clay			
24.5	31.0	Brown Silty Sand			
31.0	46.0	Brown Medium Coarse Sand			
		Flush Mount Steel Casing Set			

7 CONTRACTOR'S OR LANDOWNER'S CERTIFICATION: This water well was **1** constructed, (2) reconstructed, or (3) plugged under my jurisdiction and was completed on (mo/day/year) 10/12/89 and this record is true to the best of my knowledge and belief. Kansas Water Well Contractor's License No. 416 This Water Well Record was completed on (mo/day/yr) 11/28/89 under the business name of Terracon Consultants SE, Inc. by (signature) [Signature]

INSTRUCTIONS: Use typewriter or ball point pen. PLEASE PRESS FIRMLY and PRINT clearly. Please fill in blanks, underline or circle the correct answers. Send top three copies to Kansas Department of Health and Environment, Office of Oil Field and Environmental Geology, Regulation and Permitting Section, Topeka, Kansas 66620-7500, Telephone: 913-862-9360. Send one to WATER WELL OWNER and retain one for your records.