


1 LOCATION OF WATER WELL: County: **Wyandotte** Fraction: **SW 1/4 NW 1/4 SE 1/4** Section Number: **28** Township Number: **T 11 S** Range Number: **R 23 EW**

Distance and direction from nearest town or city street address of well if located within city?
50 W of 1565 K-32 Highway - Bonner Springs- Kansas

2 WATER WELL OWNER: **Safety Kleen**
 RR#, St. Address, Box #: **777 Big Timber Road**
 City, State, ZIP Code: **Elgin, Illinois 60123**
 Board of Agriculture, Division of Water Resources
 Application Number:

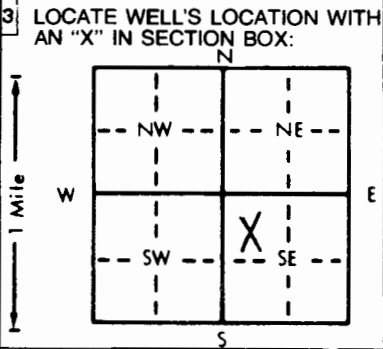

4 DEPTH OF COMPLETED WELL: **42.5'** ft. ELEVATION:
 Depth(s) Groundwater Encountered 1. **36.0'** ft. 2. ft. 3. ft.
 WELL'S STATIC WATER LEVEL **36.0'** ft. below land surface measured on **6/27/90**
 Pump test data: Well water was ft. after hours pumping gpm
 Est. Yield gpm: Well water was ft. after hours pumping gpm
 Bore Hole Diameter: **10-1/4"** to **42.5'** ft., and in. to ft.
 WELL WATER TO BE USED AS:
 5 Public water supply 8 Air conditioning 11 Injection well
 1 Domestic 3 Feedlot 6 Oil field water supply 9 Dewatering 12 Other (Specify below)
 2 Irrigation 4 Industrial 7 Lawn and garden only **10** Monitoring well
 Was a chemical/bacteriological sample submitted to Department? Yes **No**; If yes, mo/day/yr sample was submitted
 Water Well Disinfected? Yes **No**

5 TYPE OF BLANK CASING USED:
 1 Steel 3 RMP (SR) 5 Wrought iron 8 Concrete tile CASING JOINTS: Glued Clamped
2 PVC 4 ABS 7 Fiberglass Welded
 Blank casing diameter 4 in. to **27.1** ft., Dia in. to ft., Dia in. to ft.
 Casing height above land surface **30** in., weight **Sch 40** lbs./ft. Wall thickness or gauge No. **40**
 TYPE OF SCREEN OR PERFORATION MATERIAL:
 1 Steel **3** Stainless steel 5 Fiberglass 7 PVC 10 Asbestos-cement
 2 Brass 4 Galvanized steel 6 Concrete tile 8 RMP (SR) 11 Other (specify)
 9 ABS 12 None used (open hole)
 SCREEN OR PERFORATION OPENINGS ARE:
 1 Continuous slot 3 Mill slot 5 Gauzed wrapped 8 Saw cut 11 None (open hole)
6 Wire wrapped 9 Drilled holes
 2 Louvered shutter 4 Key punched 7 Torch cut 10 Other (specify)
 SCREEN-PERFORATED INTERVALS: From **27.1'** ft. to **42.5'** ft., From ft. to ft.
 From ft. to ft., From ft. to ft.
 GRAVEL PACK INTERVALS: From **24.0'** ft. to **42.5'** ft., From ft. to ft.
 From ft. to ft., From ft. to ft.

6 GROUT MATERIAL: **1** Neat cement **2** Cement grout **3** Bentonite 4 Other
 Grout Intervals: From **1.0** ft. to **21.7** ft., From **21.7** ft. to **24.0** ft., From ft. to ft.
 What is the nearest source of possible contamination:
 1 Septic tank 4 Lateral lines 7 Pit privy 10 Livestock pens 14 Abandoned water well
 2 Sewer lines 5 Cess pool 8 Sewage lagoon 11 Fuel storage 15 Oil well/Gas well
 3 Watertight sewer lines 6 Seepage pit 9 Feedyard 12 Fertilizer storage 16 Other (specify below)
 13 Insecticide storage **Underground Tanks**
 Direction from well? How many feet?

FROM	TO	LITHOLOGIC LOG	FROM	TO	PLUGGING INTERVALS
0.0	25.0	Silty clays			
25.0	29.3	Brown silty sand			
29.3	39.5	Brown Fine-medium sand			
39.5	43.5	Brown medium-course sand			
43.5	45.5	Brown fine-medium sand			
		T.D. 45.5			
		Protective casing, pad & posts set			

7 CONTRACTOR'S OR LANDOWNER'S CERTIFICATION: This water well was **1** constructed, (2) reconstructed, or (3) plugged under my jurisdiction and was completed on (mo/day/year) **6/26/90** and this record is true to the best of my knowledge and belief. Kansas Water Well Contractor's License No. **416** This Water Well Record was completed on (mo/day/yr) **6/27/90** under the business name of **Terracon Consultants SE, Inc.** by (signature) *[Signature]*

INSTRUCTIONS: Use typewriter or ball point pen. PLEASE PRESS FIRMLY and PRINT clearly. Please fill in blanks, underline or circle the correct answers. Send top three copies to Kansas Department of Health and Environment, Bureau of Water, Topeka, Kansas 66620-7320. Telephone: 913-296-5545. Send one to WATER WELL OWNER and retain one for your records.