


1 LOCATION OF WATER WELL:	Fraction	Section Number	Township Number	Range Number
County: <u>WYANDOTTE</u>	<u>NE</u> $\frac{1}{4}$ <u>NE</u> $\frac{1}{4}$ <u>SE</u> $\frac{1}{4}$	<u>12</u>	<u>T</u> <u>11</u> <u>S</u>	<u>R</u> <u>24</u> <u>EW</u>

Distance and direction from nearest town or city street address of well if located within city?

4800 KAW DRIVE, KANSAS CITY, KANSAS

2 WATER WELL OWNER: FOREST VIEW LANDFILL MONUMENT NO. M-55  
RR#, St. Address, Box # : 4800 KAW DRIVE Board of Agriculture, Division of Water Resources  
City, State, ZIP Code : KANSAS CITY, KS 66102 Application Number:

3 LOCATE WELL'S LOCATION WITH AN "X" IN SECTION BOX: 4 DEPTH OF COMPLETED WELL 61 ft. ELEVATION: \_\_\_\_\_

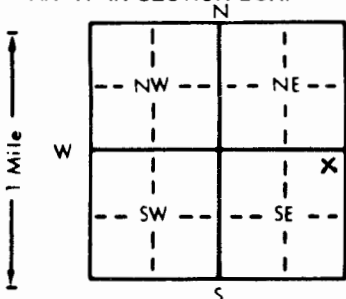

4] DEPTH OF COMPLETED WELL... 61 ft. ELEVATION: \_\_\_\_\_

Depth(s) Groundwater Encountered 1. \_\_\_\_\_ ft. 2. \_\_\_\_\_ ft. 3. \_\_\_\_\_ ft.

WELL'S STATIC WATER LEVEL  $\emptyset$  ft. below land surface measured on mo/day/yr \_\_\_\_\_

Pump test data: Well water was \_\_\_\_\_ ft. after \_\_\_\_\_ hours pumping \_\_\_\_\_ gpm

Est. Yield \_\_\_\_\_ gpm: Well water was \_\_\_\_\_ ft. after \_\_\_\_\_ hours pumping \_\_\_\_\_ gpm

Bore Hole Diameter \_\_\_\_\_ in. to \_\_\_\_\_ ft., and \_\_\_\_\_ in. to \_\_\_\_\_ ft.

WELL ~~WATER~~ TO BE USED AS:

1 Domestic	3 Feedlot	6 Oil field water supply	9 Dewatering	12 Other (Specify below)
2 Irrigation	4 Industrial	7 Lawn and garden only	10 Monitoring well	

**SURVEY MONUMENT**

Was a chemical/bacteriological sample submitted to Department? Yes \_\_\_\_\_ No \_\_\_\_\_; If yes, mo/day/yr sample was submitted \_\_\_\_\_

Water Well Disinfected? Yes \_\_\_\_\_ No \_\_\_\_\_

5 TYPE OF BLANK CASING USED:		5 Wrought iron	8 Concrete tile	CASING JOINTS: Glued . . . . . Clamped . . . . .	
1 Steel	3 RMP (SR)	6 Asbestos-Cement	9 Other (specify below)	Welded . . . . .	
2 PVC	4 <del>ABS</del>	7 Fiberglass	<u>OPEN 6" R</u>	Threaded . . . . .	

Blank casing diameter  $\phi 1.944$  in. to . ft., Dia. in. to . ft., Dia. in. to . ft.  
Casing height above land surface  $\phi 1.944$  in. weight lbs./ft. Wall thickness or gauge No.

TYPE OF SCREEN OR PERFORATION MATERIAL:			7 PVC	10 Asbestos-cement
1 Steel	3 Stainless steel	5 Fiberglass	8 RMP (SR)	11 Other (specify) .....
2 Brass	4 Galvanized steel	6 Concrete tile	9 ABS	12 <u>None used (open hole)</u>

SCREEN OR PERFORATION OPENINGS ARE:

1 Continuous slot	3 Mill slot	5 Gauzed wrapped	8 Saw cut	11 <u>None (open hole)</u>
2 Louvered shutter	4 Key punched	6 Wire wrapped	9 Drilled holes	
		7 Torch cut	10 Other (specify) .....	

SCREEN-PERFORATED INTERVALS: From NA ft. to NA ft., From \_\_\_\_\_ ft. to \_\_\_\_\_ ft.  
From \_\_\_\_\_ ft. to \_\_\_\_\_ ft., From \_\_\_\_\_ ft. to \_\_\_\_\_ ft.  
GRAVEL PACK INTERVALS: From \_\_\_\_\_ ft. to \_\_\_\_\_ ft., From \_\_\_\_\_ ft. to \_\_\_\_\_ ft.  
From \_\_\_\_\_ ft. to \_\_\_\_\_ ft., From \_\_\_\_\_ ft. to \_\_\_\_\_ ft.

6 GROUT MATERIAL: 1 Neat cement 2 Cement grout 3 Bentonite 4 Other  
Grout Intervals: From 0 ft. to 67 ft. From ft. to ft. From ft. to ft.

What is the nearest source of possible contamination:

1 Septic tank	4 Lateral lines	7 Pit privy	10 Livestock pens	14 Abandoned water well
2 Sewer lines	5 Cess pool	8 Sewage lagoon	11 Fuel storage	15 Oil well/Gas well
3 Watertight sewer lines	6 Seepage pit	9 Feedyard	12 Fertilizer storage	(16) Other (specify below)
			13 Insecticide storage	SANITARY LANDFILL

Direction from well? \_\_\_\_\_ How many feet? ON SAME PROPERTY

[illegible]

7. CONTRACTOR'S OR LANDOWNER'S CERTIFICATION: This <sup>MONUMENT</sup>~~water well~~ was (1) constructed, (2) reconstructed, or (3) plugged under my jurisdiction and was completed on (mo/day/year) . . . . 3-6-95 . . . . . and this record is true to the best of my knowledge and belief. Kansas Water Well Contractor's License No. . . . 102 . . . . . This Water Well Record was completed on (mo/day/yr) . . . . 3-24-95 . . . . . under the business name of LAYNE-WESTERN COMPANY . . . . . by (signature) [Signature]