WATER WELL RECORD Form WWC-5 KSA 82a-1212

1 LOCATION OF WATER WELL: County: WYANDOTTE	Fraction: SW ¼ SW ¼ NE ¼	Section Number: 13	Township Number: T 11 S	Range Number: R 24 (E/W)

Distance and direction from nearest town or city street address of well if located within city?
The well is located on the Ashland Chemical Property

2 WATER WELL OWNER: Ashland Chemical
RR#, St. Address, Box # : 5420 Speaker Road
City, State, ZIP Code : Kansas City KS 66106

Board of Agriculture, Division of Water Resources
Application Number:

3 LOCATE WELL'S LOCATION WITH AN "X" IN SECTION BOX:

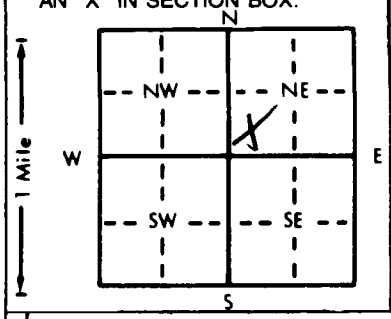

4 DEPTH OF COMPLETED WELL 58.7 ft. ELEVATION: 760 ±
Depth(s) Groundwater Encountered 1. 43 ft. 2. ft. 3. ft.
WELL'S STATIC WATER LEVEL 41.5 ft. below land surface measured on mo/day/yr 9/14/00
Pump test data: Well water was N/A ft. after hours pumping gpm
Est. Yield gpm: Well water was ft. after hours pumping gpm
Bore Hole Diameter 10 in. to 60 ft., and in. to ft.
WELL WATER TO BE USED AS: 5 Public water supply 8 Air conditioning 11 Injection well
1 Domestic 3 Feedlot 6 Oil field water supply 9 Dewatering (12) Other (Specify below)
2 Irrigation 4 Industrial 7 Lawn and garden only 10 Monitoring well Soil vapor extraction
Was a chemical/bacteriological sample submitted to Department? Yes No ✓; If yes, mo/day/yr sample was submitted
Water Well Disinfected? Yes No ✓

5 TYPE OF BLANK CASING USED: 5 Wrought iron 8 Concrete tile CASING JOINTS: Glued Clamped
1 Steel 3 RMP (SR) 6 Asbestos-Cement 9 Other (specify below) Welded
(2) PVC 4 ABS 7 Fiberglass Threaded
Blank casing diameter 2 in. to 8.7 ft., Dia 2 in. to 48-54 ft., Dia in. to ft.
Casing height above land surface N/A in., weight lbs./ft. Wall thickness or gauge No. N/A
TYPE OF SCREEN OR PERFORATION MATERIAL: (7) PVC 10 Asbestos-cement
1 Steel 3 Stainless steel 5 Fiberglass 8 RMP (SR) 11 Other (specify)
2 Brass 4 Galvanized steel 6 Concrete tile 9 ABS 12 None used (open hole)
SCREEN OR PERFORATION OPENINGS ARE: 5 Gauzed wrapped 8 Saw cut 11 None (open hole)
1 Continuous slot (3) Mill slot 6 Wire wrapped 9 Drilled holes
2 Louvered shutter 4 Key punched 7 Torch cut 10 Other (specify)
SCREEN-PERFORATED INTERVALS: From 8.7 ft. to 47.7 ft., From 53.7 ft. to 57.7 ft.
From ft. to ft., From ft. to ft.
GRAVEL PACK INTERVALS: From 7.2 ft. to 48 ft., From 52 ft. to 58.7 ft.
From ft. to ft., From ft. to ft.

6 GROUT MATERIAL: (1) Neat cement (2) Cement grout (3) Bentonite 4 Other
Grout Intervals: From 2.0 ft. to 5.2 Cement ft., From 5.2 ft. to 7.2 Bentonite ft., From 48 ft. to 52 ft.
What is the nearest source of possible contamination: 10 Livestock pens 14 Abandoned water well
1 Septic tank 4 Lateral lines 7 Pit privy 11 Fuel storage 15 Oil well/Gas well
2 Sewer lines 5 Cess pool 8 Sewage lagoon 12 Fertilizer storage 16 Other (specify below)
3 Watertight sewer lines 6 Seepage pit 9 Feedyard 13 Insecticide storage Haz. waste storage
Direction from well? NW How many feet? 20

FROM	TO	LITHOLOGIC LOG	FROM	TO	PLUGGING INTERVALS
0	2.0	Fill (Gravel, lean clay, asphalt)			
2.0	5.0	Silt (ML)			
5.0	8.0	Silty Sand (SM)			
8.0	60.0	Poorly Graded Sand (SP)			

7 CONTRACTOR'S OR LANDOWNER'S CERTIFICATION: This water well was (1) constructed, (2) reconstructed, or (3) plugged under my jurisdiction and was completed on (mo/day/year) 9/14/00 and this record is true to the best of my knowledge and belief. Kansas Water Well Contractor's License No. 399 This Water Well Record was completed on (mo/day/yr) 9/22/00
under the business name of VRS by (signature) [signature]

INSTRUCTIONS: Use typewriter or ball point pen. *PLEASE PRESS FIRMLY* and *PRINT* clearly. Please fill in blanks, underline or circle the correct answers. Send top three copies to Kansas Department of Health and Environment, Bureau of Water, Topeka, Kansas 66620-0001. Telephone: 913-296-5545. Send one to WATER WELL OWNER and retain one for your records.