

CORRECTION TO WATER WELL RECORD (WWC-5)

The following correction(s) was made to the attached WWC-5 log in order to rectify lacking or incorrect information.

Fraction (1/4 1/4 1/4) Section-Township-Range changed:

listed as NE NE NE, 5-11N-24W

changed to NE NW NE, 5-11S-24E

Other changes: Initial statements: _____

Changed to: _____

Comments: _____

verification method: Well address, city map, and Wolcott 1:24,000

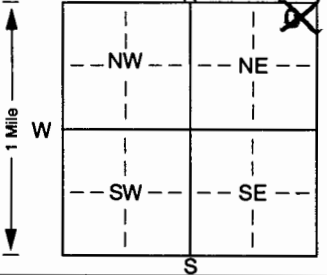
topo. map.

initials: DR date: 12/20/2002

submitted by: Kansas Geological Survey, Data Resources Library, 1930 Constant Ave., Lawrence, KS 66047-3726

to: Kansas Dept of Health & Environment Bureau of Water Industrial Programs, Bldg 283, Forbes Field, KS 66620

MW-11

1 LOCATION OF WATER WELL:		Fraction	Section Number	Township Number	Range Number
County: Wyandotte		NE 1/4 NE 1/4 NE 1/4	5	T 11 N S	R 24 E
Distance and direction from nearest town or city street address of well if located within city? See attached Map 8037 Parallel, Kansas City, KS.					
2 WATER WELL OWNER: SBC Services, Inc.					
RR#, St. Address, Box #: 308 S. Ackard, Room 900					
City, State, ZIP Code: Dallas, Texas 75202-5399					
Board of Agriculture, Division of Water Resources Application Number:					
3 LOCATE WELL'S LOCATION WITH AN "X" IN SECTION BOX:		4 DEPTH OF COMPLETED WELL: 147 ft. ELEVATION:			
		Depth(s) Groundwater Encountered 1 ft. 2. ft. 3. ft.			
WELL'S STATIC WATER LEVEL 6.5 ft. below land surface measured on mo/day/yr 6-28-01					
Pump test data: Well water was . ft. after . hours pumping . gpm					
Est. Yield . gpm: Well water was . ft. after . hours pumping . gpm					
Bore Hole Diameter 8.25 in. to . ft., and . in. to . ft.					
WELL WATER TO BE USED AS: 5 Public water supply 8 Air conditioning 11 Injection well					
1 Domestic 3 Feedlot 6 Oil field water supply 9 Dewatering 12 Other (Specify below)					
2 Irrigation 4 Industrial 7 Domestic (lawn & garden) 10 Monitoring well					
Was a chemical/bacteriological sample submitted to Department? Yes. No. If yes, mo/day/yr sample was submitted					
Water Well Disinfected? Yes No					
5 TYPE OF BLANK CASING USED: 5 Wrought iron 8 Concrete tile CASING JOINTS: Glued. Clamped.					
1 Steel 3 RMP (SR) 6 Asbestos-Cement 9 Other (specify below) Welded					
2 PVC 4 ABS 7 Fiberglass Threaded					
Blank casing diameter . in. to . ft., Dia . in. to . ft., Dia . in. to . ft.					
Casing height above land surface . in., weight . lbs./ft. Wall thickness or gauge No. Sch 40					
TYPE OF SCREEN OR PERFORATION MATERIAL: 7 PVC 10 Asbestos-cement					
1 Steel 3 Stainless steel 5 Fiberglass 8 RMP (SR) 11 Other (specify)					
2 Brass 4 Galvanized steel 6 Concrete tile 9 ABS 12 None used (open hole)					
SCREEN OR PERFORATION OPENINGS ARE: 5 Gauzed wrapped 8 Saw cut 11 None (open hole)					
1 Continuous slot 3 Mill slot 6 Wire wrapped 9 Drilled holes					
2 Louvered shutter 4 Key punched 7 Torch cut 10 Other (specify) . ft.					
SCREEN-PERFORATED INTERVALS: From . ft. to . ft. From . ft. to . ft. From . ft. to . ft.					
GRAVEL PACK INTERVALS: From . ft. to . ft. From . ft. to . ft. From . ft. to . ft.					
6 GROUT MATERIAL: 1 Neat cement 2 Cement grout 3 Bentonite 4 Other					
Grout Intervals: From . ft. to . ft. From . ft. to . ft. From . ft. to . ft.					
What is the nearest source of possible contamination: 10 Livestock pens 14 Abandoned water well					
1 Septic tank 4 Lateral lines 7 Pit privy 11 Fuel storage 15 Oil well/Gas well					
2 Sewer lines 5 Cess pool 8 Sewage lagoon 12 Fertilizer storage 16 Other (specify below)					
3 Watertight sewer lines 6 Seepage pit 9 Feedyard 13 Insecticide storage					
Direction from well? How many feet?					
FROM TO LITHOLOGIC LOG FROM TO PLUGGING INTERVALS					
0 3' Grass/soil 0 1.5' Concrete					
3 3' Light Brown Clay 1.5 1.5' Bentonite					
3 3' Light Brown Clay w/ grey 1.5 14' Sand					
3 10' Light Brown clay w/ traces of sandstone rock					
10 13' Sandy/clay mix some rock					
13 14' Shale					
7 CONTRACTOR'S OR LANDOWNER'S CERTIFICATION: This water well was (1) constructed, (2) reconstructed, or (3) plugged under my jurisdiction and was completed on (mo/day/year) 5/8/01 and this record is true to the best of my knowledge and belief. Kansas Water Well Contractor's Licence No. 416 This Water Well Record was completed on (mo/day/yr) 7-27-01 under the business name of Terracon, Inc. by (signature) Anthony J. Paulter					
INSTRUCTIONS: Use typewriter or ball point pen. PLEASE PRESS FIRMLY and PRINT clearly. Please fill in blanks, underline or circle the correct answers. Send top three copies to Kansas Department of Health and Environment, Bureau of Water, Topeka, Kansas 66620-0001. Telephone 785-296-5524. Send one to WATER WELL OWNER and retain one for your records. Fee of \$5.00 for each constructed well.					