

# CORRECTION TO WATER WELL RECORD (WWC-5)

The following correction(s) was made to the attached WWC-5 log in order to rectify lacking or incorrect information.

Fraction ( 1/4 1/4 1/4) Section-Township-Range changed:

listed as NE NE NE, 5-11N-24W

changed to NE NW NE, 5-11S-24E

Other changes: Initial statements: \_\_\_\_\_

Changed to: \_\_\_\_\_

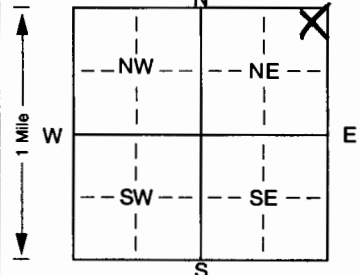
Comments: \_\_\_\_\_

verification method: Well address, city map, and Wolcott 1:24,000  
topo. map.

initials: DR date: 12/20/2002

submitted by: Kansas Geological Survey, Data Resources Library, 1930 Constant Ave., Lawrence, KS 66047-3726  
to: Kansas Dept of Health & Environment Bureau of Water Industrial Programs, Bldg 283, Forbes Field, KS 66620

MW-13

1 LOCATION OF WATER WELL:		Fraction	Section Number	Township Number	Range Number
County: Wyandotte		NE 1/4 NE 1/4 NE 1/4	5	T 11 N S	R 24 E/W
Distance and direction from nearest town or city street address of well if located within city? See attached Map 8037 Parallel PKWY Kansas City, KS					
2 WATER WELL OWNER: SBC Services					
RR#, St. Address, Box #: 308 South Hickard Room 900					
City, State, ZIP Code: Dallas, Texas 75202-5399					
Board of Agriculture, Division of Water Resources Application Number:					
3 LOCATE WELL'S LOCATION WITH		4 DEPTH OF COMPLETED WELL			
AN "X" IN SECTION BOX:		ft. ELEVATION:			
		Depth(s) Groundwater Encountered 1 ft. 2. ft. 3. ft.			
		WELL'S STATIC WATER LEVEL 7.45 ft. below land surface measured on mo/day/yr 6-28-01			
		Pump test data: Well water was ft. after hours pumping gpm			
		Est. Yield gpm: Well water was ft. after hours pumping gpm			
		Bore Hole Diameter 8.25 in. to ft. and in. to ft.			
		WELL WATER TO BE USED AS: 5 Public water supply 8 Air conditioning 11 Injection well			
		1 Domestic 3 Feedlot 6 Oil field water supply 9 Dewatering 12 Other (Specify below)			
		2 Irrigation 4 Industrial 7 Domestic (lawn & garden) 10 Monitoring well			
		Was a chemical/bacteriological sample submitted to Department? Yes No; If yes, mo/day/yr sample was submitted			
		Water Well Disinfected? Yes No			
5 TYPE OF BLANK CASING USED:					
1 Steel 3 RMP (SR) 5 Wrought iron 8 Concrete tile CASING JOINTS: Glued. Clamped.					
2 PVC 4 ABS 6 Asbestos-Cement 9 Other (specify below) Welded					
7 Fiberglass Threaded					
Blank casing diameter 2 in. to ft. Dia in. to ft. Dia in. to ft.					
Casing height above land surface 0 in., weight lbs./ft. Wall thickness or gauge No. SCH 40					
TYPE OF SCREEN OR PERFORATION MATERIAL:					
1 Steel 3 Stainless steel 5 Fiberglass 7 PVC 10 Asbestos-cement					
2 Brass 4 Galvanized steel 6 Concrete tile 8 RMP (SR) 11 Other (specify)					
9 ABS 12 None used (open hole)					
SCREEN OR PERFORATION OPENINGS ARE:					
1 Continuous slot 3 Mill slot 5 Gauzed wrapped 8 Saw cut 11 None (open hole)					
2 Louvered shutter 4 Key punched 6 Wire wrapped 9 Drilled holes 10 Other (specify) ft.					
7 Torch cut					
SCREEN-PERFORATED INTERVALS: From 8 ft. to 23 ft. From ft. to ft.					
GRAVEL PACK INTERVALS: From 3.5 ft. to 23 ft. From ft. to ft.					
From ft. to ft. From ft. to ft.					
6 GROUT MATERIAL: 1 Neat cement 2 Cement grout 3 Bentonite 4 Other					
Grout Intervals: From ft. to ft. From ft. to ft. From ft. to ft.					
What is the nearest source of possible contamination:					
1 Septic tank 4 Lateral lines 7 Pit privy 10 Livestock pens 14 Abandoned water well					
2 Sewer lines 5 Cess pool 8 Sewage lagoon 11 Fuel storage 15 Oil well/Gas well					
3 Watertight sewer lines 6 Seepage pit 9 Feedyard 12 Fertilizer storage 16 Other (specify below)					
13 Insecticide storage					
Direction from well? How many feet?					
FROM TO LITHOLOGIC LOG FROM TO PLUGGING INTERVALS					
0 0.5 Concrete					
0.5 1.5 Sand/gravel					
1.5 5.0 Brn sandy clay Moist					
5 10 Brn sandy clay Petro odor					
10 15 Brn sandy clay/gravel					
15 18 Dark Brn clay					
18 23 Shale					
0 2 Concrete					
2 3.5 Bentonite					
3.5 23 Sand					
7 CONTRACTOR'S OR LANDOWNER'S CERTIFICATION: This water well was (1) constructed, (2) reconstructed, or (3) plugged under my jurisdiction and was completed on (mo/day/year) 5/11/01 and this record is true to the best of my knowledge and belief. Kansas Water Well Contractor's Licence No. 416 This Water Well Record was completed on (mo/day/yr) 7-27-01 under the business name of Terralco, INC. by (signature) Anthony J. Pauter					
INSTRUCTIONS: Use typewriter or ball point pen. PLEASE PRESS FIRMLY and PRINT clearly. Please fill in blanks, underline or circle the correct answers. Send top three copies to Kansas Department of Health and Environment, Bureau of Water, Topeka, Kansas 66620-0001. Telephone 785-296-5524. Send one to WATER WELL OWNER and retain one for your records. Fee of \$5.00 for each constructed well.					