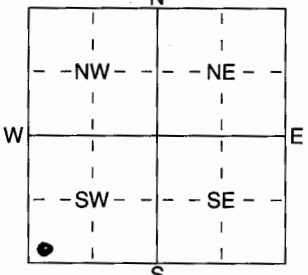


1 LOCATION OF WATER WELL: Fraction SW 1/4 SW 1/4 SW 1/4 Section Number 4 Township Number T 11 S Range Number R 24 E
 County: Wyandotte

Distance and direction from nearest town or city street address of well if located within city?
7740 State Ave, Kansas City, Ks.

2 WATER WELL OWNER: Shell Oil Products, U.S.
 RR#, St. Address, Box #: 308 Wilcox #101 Board of Agriculture, Division of Water Resources
 City, State, ZIP Code: Castle Rock, Colo. 80104 Application Number:

3 LOCATE WELL'S LOCATION WITH AN "X" IN SECTION BOX:

 4 DEPTH OF COMPLETED WELL 10'8" ft. ELEVATION:
 Depth(s) Groundwater Encountered 1 --- ft. 2 --- ft. 3 --- ft.
 WELL'S STATIC WATER LEVEL Dry ft. below land surface measured on mo/day/yr 8-5-04
 Pump test data: Well water was --- ft. after --- hours pumping --- gpm
 Est. Yield --- gpm: Well water was --- ft. after --- hours pumping --- gpm
 WELL TO BE USED AS:
 1 Domestic 3 Feedlot 6 Oil field water supply 8 Dewatering 11 Injection well
 2 Irrigation 4 Industrial 7 Domestic (lawn & garden) 10 Monitoring well 12 Other (Specify below)
 Was a chemical/bacteriological sample submitted to Department? Yes No; If yes, mo/day/yr sample was submitted
 Water Well Disinfected? Yes No

5 TYPE OF BLANK CASING USED:
 1 Steel 3 RMP (SR) 5 Wrought iron 8 Concrete tile CASING JOINTS: Glued --- Clamped ---
 2 PVC 4 ABS 6 Asbestos-Cement 9 Other (specify below) Welded ---
 7 Fiberglass Threaded X
 Blank casing diameter 2.375 in. to 3'6" ft., Dia --- in. to --- ft., Dia --- in. to --- ft.
 Casing height above land surface FLUSH ML in., weight --- lbs./ft. Wall thickness or gauge No. Sch 40
 TYPE OF SCREEN OR PERFORATION MATERIAL:
 1 Steel 3 Stainless Steel 5 Fiberglass 8 RMP (SR) 10 Asbestos-Cement
 2 Brass 4 Galvanized Steel 6 Concrete tile 9 ABS 11 Other (Specify) ---
 12 None used (open hole)
 SCREEN OR PERFORATION OPENINGS ARE:
 1 Continuous slot 3 Mill slot 5 Gauzed wrapped 8 Saw cut 11 None (open hole)
 2 Louvered shutter 4 Key punched 6 Wire wrapped 9 Drilled holes
 7 Torch cut 10 Other (specify) --- ft.
 SCREEN-PERFORATED INTERVALS: From 10'6" ft. to 3'6" ft., From --- ft. to --- ft.
 GRAVEL PACK INTERVALS: From 10'8" ft. to 2' ft., From --- ft. to --- ft.

6 GROUT MATERIAL: 1 Neat cement 2 Cement grout 3 Bentonite 4 Other Concrete
 Grout Intervals: From 2' ft. to 1' ft., From 1' ft. to 0' ft., From --- ft. to --- ft.
 What is the nearest source of possible contamination:
 1 Septic tank 4 Lateral lines 7 Pit privy 10 Livestock pens 14 Abandoned water well
 2 Sewer lines 5 Cess pool 8 Sewage lagoon 11 Fuel storage 15 Oil well/Gas well
 3 Watertight sewer lines 6 Seepage pit 9 Feedyard 12 Fertilizer storage 16 Other (specify below)
 13 Insecticide storage
 Direction from well? North How many feet? 30'

FROM	TO	LITHOLOGIC LOG	FROM	TO	PLUGGING INTERVALS
		<u>Concrete</u>			
<u>0</u>	<u>3.0</u>	<u>yellow Ben clay w/ gravel, dry</u>			RECEIVED
<u>3.0</u>	<u>7.0</u>	<u>Rug Ben to yellow Ben weathered sandstone and shale, dry</u>			AUG 31 2004
<u>7.0</u>	<u>10.8</u>	<u>olive gray shale, dry, no odor</u>			BUREAU OF WATER
					<u>F.M. OK'd by Don Taylor</u>

7 CONTRACTOR'S OR LANDOWNER'S CERTIFICATION: This water well was (1) constructed (2) reconstructed, or (3) plugged under my jurisdiction and was completed on (mo/day/year) 7-19-04 and this record is true to the best of my knowledge and belief. Kansas Water Well Contractor's Licence No 732 This Water Well Record was completed on (mo/day/yr) 8-23-04 under the business name of JB Env. Service & Supply by (signature) James Becker