


1 LOCATION OF WATER WELL: Fraction SW 1/4 SW 1/4 SW 1/4 Section Number 4 Township Number T 11 S Range Number R 24 E/W
 County: Wyandotte

Distance and direction from nearest town or city street address of well if located within city?
7740 State Ave; Kansas City, Ks.

2 WATER WELL OWNER: Shell Oil Products; U.S.
 RR#, St. Address, Box #: 308 Wilcox #101 Board of Agriculture, Division of Water Resources
 City, State, ZIP Code: Castle Rock, Colo 80104 Application Number:

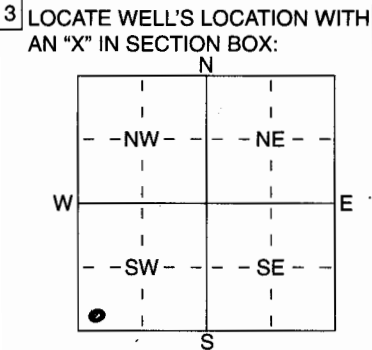

4 DEPTH OF COMPLETED WELL 14' ft. ELEVATION: ft.
 Depth(s) Groundwater Encountered 1 10' ft. 2 ft. 3 ft.
 WELL'S STATIC WATER LEVEL Dry ft. below land surface measured on mo/day/yr 8-5-04
 Pump test data: Well water was ft. after hours pumping gpm
 Est. Yield gpm: Well water was ft. after hours pumping gpm
 WELL WATER TO BE USED AS:
 1 Domestic 3 Feedlot 6 Oil field water supply 9 Dewatering 12 Other (Specify below)
 2 Irrigation 4 Industrial 7 Domestic (lawn & garden) 10 Monitoring well
 Was a chemical/bacteriological sample submitted to Department? Yes No X; If yes, mo/day/yr sample was submitted
 Water Well Disinfected? Yes No

5 TYPE OF BLANK CASING USED:
 1 Steel 2 PVC 3 RMP (SR) 4 ABS 5 Wrought iron 6 Asbestos-Cement 7 Fiberglass 8 Concrete tile 9 Other (specify below) CASING JOINTS: Glued Clamped
 Welded Threaded X
 Blank casing diameter 2.375 in. to 4' ft., Dia in. to ft., Dia in. to ft.
 Casing height above land surface Flush Mt. in., weight lbs./ft. Wall thickness or gauge No. Sch 40
 TYPE OF SCREEN OR PERFORATION MATERIAL:
 1 Steel 3 Stainless Steel 5 Fiberglass 8 RMP (SR) 10 Asbestos-Cement 11 Other (Specify)
 2 Brass 4 Galvanized Steel 6 Concrete tile 9 ABS 12 None used (open hole)
 SCREEN OR PERFORATION OPENINGS ARE:
 1 Continuous slot 2 Louvered shutter 3 Mill slot 4 Key punched 5 Gauzed wrapped 6 Wire wrapped 7 Torch cut 8 Saw cut 9 Drilled holes 10 Other (specify) ft.
 SCREEN-PERFORATED INTERVALS: From 14' ft. to 4' ft., From ft. to ft.
 GRAVEL PACK INTERVALS: From 14' ft. to 3' ft., From ft. to ft.

6 GROUT MATERIAL: 1 Neat cement 2 Cement grout 3 Bentonite 4 Other concrete
 Grout Intervals: From 3' ft. to 1 1/2' ft., From 1 1/2' ft. to surface ft., From ft. to ft.
 What is the nearest source of possible contamination:
 1 Septic tank 4 Lateral lines 7 Pit privy 10 Livestock pens 14 Abandoned water well
 2 Sewer lines 5 Cess pool 8 Sewage lagoon 11 Fuel storage 15 Oil well/Gas well
 3 Watertight sewer lines 6 Seepage pit 9 Feedyard 12 Fertilizer storage 16 Other (specify below)
 Direction from well? North How many feet? 20'

FROM	TO	LITHOLOGIC LOG	FROM	TO	PLUGGING INTERVALS
0	2.0	Bin clay w/ls. rk gravel and concrete rubble, fill			RECEIVED
2.0	4.0	Rusty bent yellow bin sandy clay w/few sandstone fragments, dry			AUG 31 2004
4.0	11.0	Yellow bin-Olive gray shale, dry light, no odor			BUREAU OF WATER
11.0	14.0	Brd dense crystalline chertstone well hard			F.M. OK'd by D. Taylor

7 CONTRACTOR'S OR LANDOWNER'S CERTIFICATION: This water well was (1 constructed (2) reconstructed, or (3) plugged under my jurisdiction and was completed on (mo/day/year) 7-19-04 and this record is true to the best of my knowledge and belief. Kansas Water Well Contractor's Licence No. 732 This Water Well Record was completed on (mo/day/yr) 8-23-04 under the business name of QB Env. Service & Supply by (signature) James Beebe

INSTRUCTIONS: Use typewriter or ball point pen. PLEASE PRESS FIRMLY and PRINT clearly. Please fill in blanks, underline or circle the correct answers. Send top three copies to Kansas Department of Health and Environment, Bureau of Water, Geology Section, 1000 SW Jackson St., Suite 420, Topeka, Kansas 66612-1367. Telephone 785-296-5522. Send one to WATER WELL OWNER and retain one for your records. Fee of \$5.00 for each constructed well.