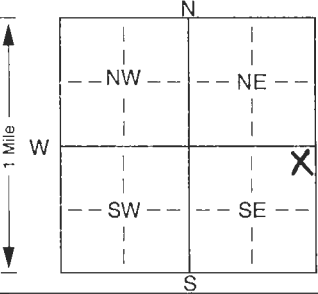


1 LOCATION OF WATER WELL: Fraction <u>NE 1/4 NE 1/4 SE 1/4</u> Section Number <u>5</u> Township Number <u>T 11 S</u> Range Number <u>R 24 E</u>					
County: <u>Wyandotte</u> Distance and direction from nearest town or city street address of well if located within city? <u>7850 Freeman Avenue, Kansas City, KS</u>					
2 WATER WELL OWNER: <u>KC Presbyterian Manor</u> Board of Agriculture, Division of Water Resources RR#, St. Address, Box #: <u>7850 Freeman Ave.</u> Application Number: <u>MW5</u> City, State, ZIP Code: <u>Kansas City, KS 66112</u>					
3 LOCATE WELL'S LOCATION WITH AN "X" IN SECTION BOX: 					
4 DEPTH OF COMPLETED WELL: _____ ft. ELEVATION: _____ ft. Depth(s) Groundwater Encountered 1. _____ ft. 2. _____ ft. 3. _____ ft. WELL'S STATIC WATER LEVEL <u>12.45</u> ft. below land surface measured on mo/day/yr _____ Pump test data: Well water was _____ ft. after _____ hours pumping _____ gpm Est. Yield _____ gpm: Well water was _____ ft. after _____ hours pumping _____ gpm Bore Hole Diameter: _____ in. to _____ ft., and _____ in. to _____ ft. WELL WATER TO BE USED AS: 5 Public water supply 8 Air conditioning 11 Injection well 1 Domestic 3 Feedlot 6 Oil field water supply 9 Dewatering 12 Other (Specify below) 2 Irrigation 4 Industrial 7 Domestic (lawn & garden) <u>10 Monitoring well</u> Was a chemical/bacteriological sample submitted to Department? Yes. _____ No. _____; If yes, mo/day/yr sample was submitted _____ Water Well Disinfected? Yes _____ No _____					
5 TYPE OF BLANK CASING USED: 1 Steel 3 RMP (SR) 5 Wrought iron 8 Concrete tile CASING JOINTS: Glued. _____ Clamped. _____ <u>2 PVC</u> 4 ABS 6 Asbestos-Cement 9 Other (specify below) <u>Welded</u> 7 Fiberglass <u>Threaded</u> Blank casing diameter <u>2</u> in. to <u>4</u> ft., Dia _____ in. to _____ ft., Dia _____ in. to _____ ft. Casing height above land surface: _____ in., weight _____ lbs./ft. Wall thickness or gauge No. _____ TYPE OF SCREEN OR PERFORATION MATERIAL: <u>7 PVC</u> 10 Asbestos-cement 1 Steel 3 Stainless steel 5 Fiberglass 8 RMP (SR) 11 Other (specify) _____ 2 Brass 4 Galvanized steel 6 Concrete tile 9 ABS 12 None used (open hole) SCREEN OR PERFORATION OPENINGS ARE: 5 Gauzed wrapped 8 Saw cut 11 None (open hole) 1 Continuous slot <u>3 Mill slot</u> 6 Wire wrapped 9 Drilled holes 2 Louvered shutter 4 Key punched 7 Torch cut 10 Other (specify) _____ ft. SCREEN-PERFORATED INTERVALS: From <u>4</u> ft. to <u>19</u> ft., From _____ ft. to _____ ft. From _____ ft. to _____ ft., From _____ ft. to _____ ft. GRAVEL PACK INTERVALS: From <u>3</u> ft. to <u>19</u> ft., From _____ ft. to _____ ft. From _____ ft. to _____ ft., From _____ ft. to _____ ft.					
6 GROUT MATERIAL: 1 Neat cement 2 Cement grout <u>3 Bentonite</u> <u>4 Other Cement 0-2</u> Grout Intervals: From <u>2</u> ft. to <u>3</u> ft., From _____ ft. to _____ ft., From _____ ft. to _____ ft. What is the nearest source of possible contamination: 1 Septic tank 4 Lateral lines 7 Pit privy <u>10 Livestock pens</u> 14 Abandoned water well 2 Sewer lines 5 Cess pool 8 Sewage lagoon <u>11 Fuel storage Former</u> 15 Oil well/Gas well 3 Watertight sewer lines 6 Seepage pit 9 Feedyard 12 Fertilizer storage 16 Other (specify below) 13 Insecticide storage _____ Direction from well? _____ How many feet? _____					
FROM	TO	LITHOLOGIC LOG	FROM	TO	PLUGGING INTERVALS
0	1	Topsoil			Flushmount Waiver by D. Taylor
4	6	clay, light brown with gray mottles, moist			
9	11	clay, dark gray, moist			
14	16	clay, orange brown, moist			
19		sandstone/shale?			

7 CONTRACTOR'S OR LANDOWNER'S CERTIFICATION: This water well was (1) constructed, (2) reconstructed, or (3) plugged under my jurisdiction and was completed on (mo/day/year) 8/1/04 and this record is true to the best of my knowledge and belief. Kansas Water Well Contractor's Licence No. 662 This Water Well Record was completed on (mo/day/yr) 9/1/04 under the business name of Hydrologic, Inc. by (signature) [Signature]