


INSTRUCTIONS: Use typewriter or ball point pen. PLEASE PRESS FIRMLY and PRINT clearly. Please fill in blanks, underline or circle the correct answers. Send top three copies to Kansas Department of Health and Environment, Bureau of Water, Geology Section, 1000 SW Jackson St., Suite 420, Topeka, Kansas 66612-1367. Telephone 785-296-5522. Send one to WATER WELL OWNER and retain one for your records. Fee of \$5.00 for each constructed well.

**WELL LOCATIONS**  
Harcros Chemicals, Inc.  
5200 Speaker Rd.  
Kansas City, KS

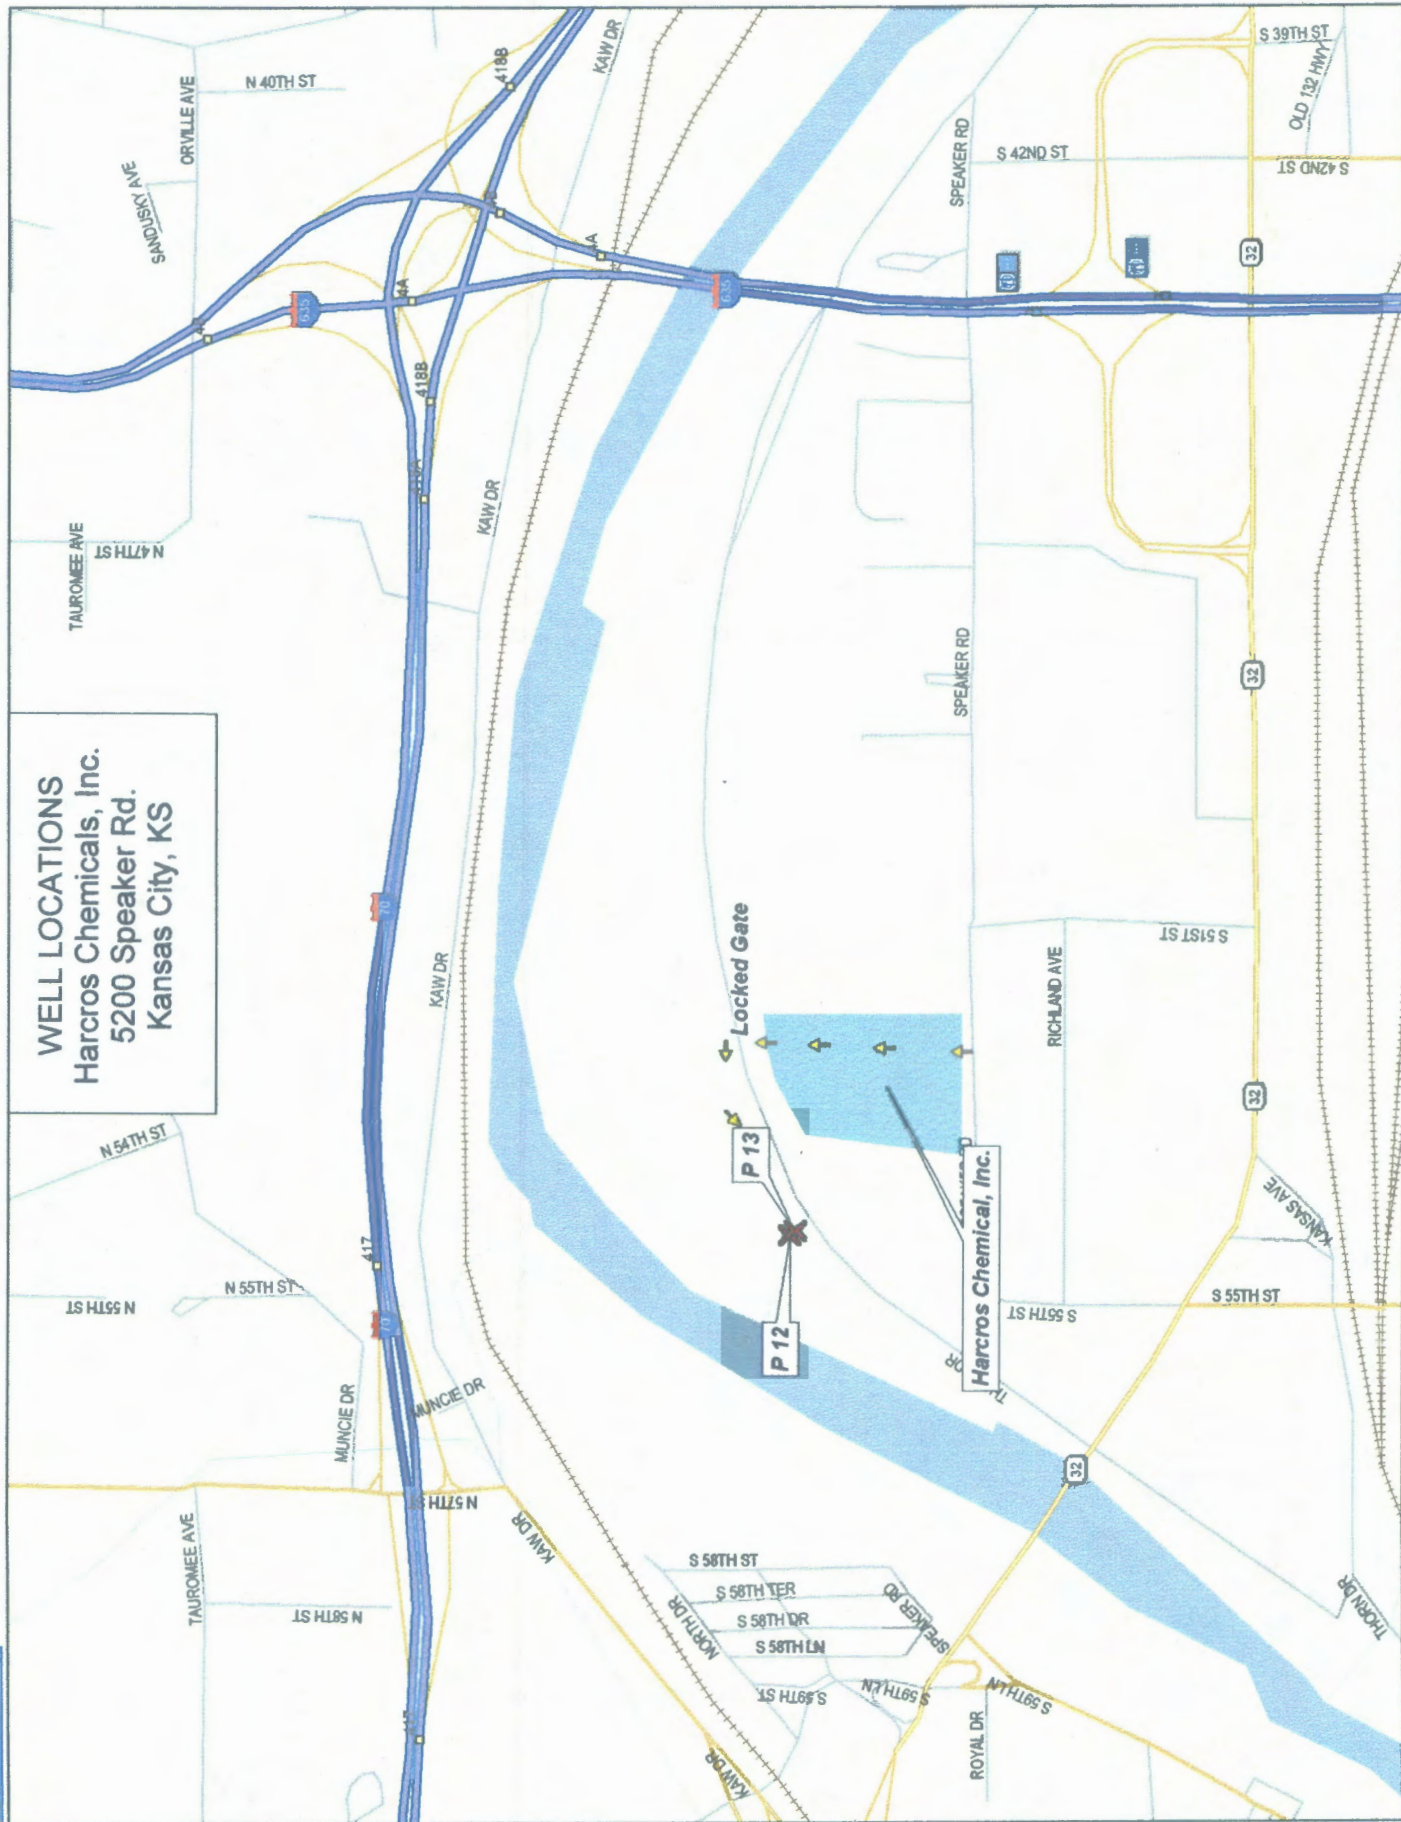

© 2003 DeLorme, Street Atlas USA® 2004.  
www.delorme.com

Scale 1 : 16,000

1" = 1,333.3 ft Data Zoom 13-6