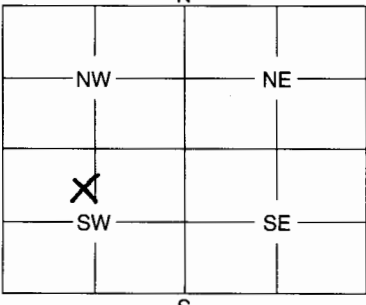


1	LOCATION OF WATER WELL:	Fraction	Section Number	Township Number	Range Number																								
	County: <u>Wyandotte</u>	<u>NW 1/4 NW 1/4 SW 1/4</u>	<u>12</u>	<u>11 S.</u>	<u>24</u> <u>QW</u>																								
Distance and direction from nearest town or city street address of well if located within city? <u>West of 4800 Kaw Drive, Kansas City, KS. 66102</u>																													
2	WATER WELL OWNER: <u>Forest View landfill, LLC.</u>																												
RR #, St. Address, Box #:		Board of Agriculture, Division of Water Resources																											
City, State, ZIP Code: <u>Kansas City, KS. 66102</u>		Application Number:																											
3	MARK WELL'S LOCATION WITH AN "X" IN SECTION BOX: <div style="text-align: center;">  </div>																												
4																													
DEPTH OF WELL <u>117.75</u> ft.		WELL'S STATIC WATER LEVEL <u>116.41</u> ft.																											
WELL WAS USED AS:																													
1 Domestic		5 Public Water Supply		9 Dewatering																									
2 Irrigation		6 Oil Field Water Supply		<u>10</u> Monitoring Well																									
3 Feedlot		7 Domestic (Lawn & Garden)		11 Injection Well																									
4 Industrial		8 Air Conditioning		12 Other .....																									
Was a chemical / bacteriological sample submitted to Department? Yes ..... No <u>X</u>																													
If yes, mo/day/yr sample was submitted .....																													
Water Well Disinfected: Yes ..... No <u>X</u>																													
5	TYPE OF BLANK CASING USED:																												
1 Steel      3 RMP (SR)      5 Wrought      7 Fiberglass      9 Other (Specify below) <u>2</u> PVC      4 ABS      6 Asbestos-Cement      8 Concrete Tile																													
Blank casing diameter <u>2</u> in.      Was casing pulled? Yes <u>X</u> No .....      If yes, how much <u>59</u> ft.																													
Casing height <u>above</u> or below land surface <u>24</u> in.																													
6	GROUT PLUG MATERIAL:      1 Neat cement      2 Cement grout <u>3</u> Bentonite      4 Other .....																												
Grout Plug Intervals:      From <u>0</u> ft. to <u>118</u> ft.,      From ..... ft. to ..... ft.,      From ..... to ..... ft.																													
What is the nearest source of possible contamination:																													
1 Septic tank		6 Seepage pit		11 Fuel storage																									
2 Sewer lines		7 Pit privy		12 Fertilizer storage																									
3 Watertight sewer lines		8 Sewage lagoon		13 Insecticide storage																									
4 Lateral lines		9 Feedyard		14 Abandoned water well																									
5 Cess pool		10 Livestock pens		15 Oil well/Gas well																									
<u>16</u> Other (specify below) <u>Land fill</u>																													
Direction from well? .....      How many feet? .....																													
<table border="1" style="width:100%; border-collapse: collapse;"> <thead> <tr> <th style="width:15%;">FROM</th> <th style="width:15%;">TO</th> <th style="width:70%;">PLUGGING MATERIALS</th> </tr> </thead> <tbody> <tr> <td><u>0'</u></td> <td><u>118'</u></td> <td><u>Bentonite chips</u></td> </tr> <tr><td> </td><td> </td><td> </td></tr> <tr><td> </td><td> </td><td> </td></tr> <tr><td> </td><td> </td><td> </td></tr> <tr><td> </td><td> </td><td> </td></tr> <tr><td> </td><td> </td><td> </td></tr> <tr><td> </td><td> </td><td> </td></tr> </tbody> </table>						FROM	TO	PLUGGING MATERIALS	<u>0'</u>	<u>118'</u>	<u>Bentonite chips</u>																		
FROM	TO	PLUGGING MATERIALS																											
<u>0'</u>	<u>118'</u>	<u>Bentonite chips</u>																											
7	CONTRACTOR'S OF LANDOWNER'S CERTIFICATION: This water well was plugged under my jurisdiction and was completed on (mo/day/year) <u>04/07/2005</u> and this record is true to the best of my knowledge and belief. Kansas Water Well Contractor's License No. <u>708</u> This Water Well Record was completed on (mo/day/year) <u>04/12/2005</u> under the business name of <u>Aquatera Environmental Solutions, Inc.</u> by (signature) <u>J. H. Glasshouse</u>																												

INSTRUCTIONS: Use typewriter or ball point pen. Please press firmly and print clearly. Please fill in blanks, underline or circle the correct answers. Send top three copies to Kansas Department of Health and Environment, Bureau of Water, Geology Section, 1000 SW Jackson St., Ste. 420, Topeka, Kansas 66612-1367. Telephone: 785/296-5522. Send one to Water Well Owner and retain one for your records.