




1 LOCATION OF WATER WELL: Fraction Section Number Township Number Range Number

County: Wyandotte SW 1/4 SW 1/4 SW 1/4 4 11 24 EW

Distance and direction from nearest town or city street address of well if located within city?
 Shell Gas Station 7740 State Ave, Kansas City, KS.

2 WATER WELL OWNER: **Shell Oil Products**
308 Wilcox #101
 RR #, St. Address, Box #: **Castle Rock, CO. 80104** Board of Agriculture, Division of Water Resources
 City, State, ZIP Code : Application Number:

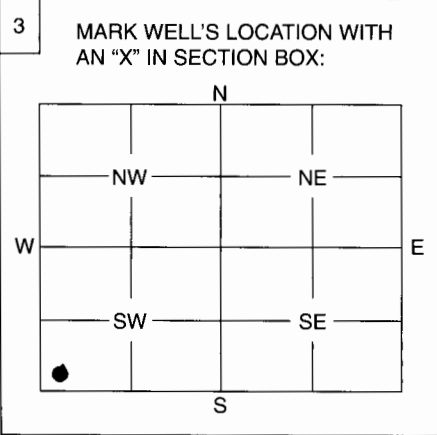

4 DEPTH OF WELL 10' ft.
 WELL'S STATIC WATER LEVEL 7.48 ft.
 WELL WAS USED AS:
 1 Domestic 2 Irrigation 3 Feedlot 4 Industrial 5 Public Water Supply 6 Oil Field Water Supply 7 Domestic (Lawn & Garden) 8 Air Conditioning 9 Dewatering 10 Monitoring Well 11 Injection Well 12 Other

Was a chemical / bacteriological sample submitted to Department? Yes No X.....
 If yes, mo/day/yr sample was submitted

Water Well Disinfected: Yes No X.....

5 TYPE OF BLANK CASING USED:
 1 Steel 2 PVC 3 RMP (SR) 4 ABS 5 Wrought 6 Asbestos-Cement 7 Fiberglass 8 Concrete Tile 9 Other (Specify below)

Blank casing diameter 2.0 in. Was casing pulled? Yes X No If yes, how much 10'

Casing height above or below land surface N/A in.

6 GROUT PLUG MATERIAL: 1 Neat cement 2 Cement grout 3 Bentonite 4 Other soil

Grout Plug Intervals: From 10' ft. to 1' ft., From 1' ft. to 0' ft., From to ft.

What is the nearest source of possible contamination? 3 4

1 Septic tank 2 Sewer lines 3 Watertight sewer lines 4 Lateral lines 5 Cess pool 6 Seepage pit 7 Pit privy 8 Sewage lagoon 9 Feedyard 10 Livestock pens 11 Fuel storage 12 Fertilizer storage 13 Insecticide storage 14 Abandoned water well 15 Oil well/Gas well 16 Other (specify below)

Direction from well? North How many feet? 40'

FROM	TO	PLUGGING MATERIALS

Flush mt manway was removed and 2" well casing was drilled and pulled out to TD. 10'

Bentonite from 10'-1'
 Cement from
 Soil from 1'-0'

7 CONTRACTOR'S OF LANDOWNER'S CERTIFICATION: This water well was plugged under my jurisdiction and was completed on (mo/day/year) 2-23-06 and this record is true to the best of my knowledge and belief. Kansas Water Well Contractor's License No. 732 This Water Well Record was completed on (mo/day/year) under the business name of QB Environmental by (signature) James Bueker

INSTRUCTIONS: Use typewriter or ball point pen. Please press firmly and print clearly. Please fill in blanks, underline or circle the correct answers. Send top three copies to Kansas Department of Health and Environment, Bureau of Water, Geology Section, 1000 SW Jackson St., Ste. 420, Topeka, Kansas 66612-1367. Telephone: 785/296-5522. Send one to Water Well Owner and retain one for your records.