


1 LOCATION OF WATER WELL: Fraction SW 1/4 SW 1/4 SW 1/4 Section Number 4 Township Number 11 Range Number 24 **EW**

Distance and direction from nearest town or city street address of well if located within city?
 Shell Gas Station **7740 State Ave, Kansas City, KS.**

2 WATER WELL OWNER: **Shell Oil Products**
308 Wilcox #101
 RR #, St. Address, Box #: **Castle Rock, CO. 80104** Board of Agriculture, Division of Water Resources
 City, State, ZIP Code : Application Number:

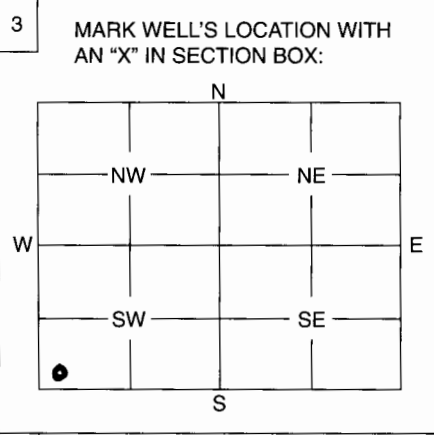

4 DEPTH OF WELL 16' ft.
 WELL'S STATIC WATER LEVEL 11.46 ft.
 WELL WAS USED AS:
 1 Domestic 5 Public Water Supply 8 Dewatering
 2 Irrigation 6 Oil Field Water Supply **10 Monitoring Well**
 3 Feedlot 7 Domestic (Lawn & Garden) 11 Injection Well
 4 Industrial 8 Air Conditioning 12 Other

Was a chemical / bacteriological sample submitted to Department? Yes No **X**.....
 If yes, mo/day/yr sample was submitted

Water Well Disinfected: Yes No **X**.....

5 TYPE OF BLANK CASING USED:
 1 Steel 3 RMP (SR) 5 Wrought 7 Fiberglass 9 Other (Specify below)
2 PVC 4 ABS 6 Asbestos-Cement 8 Concrete Tile

Blank casing diameter 2.0 in. Was casing pulled? Yes **X** No If yes, how much 16'
 Casing height above or below land surface N/A in.

6 GROUT PLUG MATERIAL: 1 Neat cement 2 Cement grout **3 Bentonite** **4 Other Soil**
 Grout Plug Intervals: From 16' ft. to 1' ft., From 1' ft. to 0 ft., From to ft.

What is the nearest source of possible contamination:
 1 Septic tank 6 Seepage pit **11 Fuel storage** 16 Other (specify below)
 2 Sewer lines 7 Pit privy **12 Fertilizer storage**

Direction from well? North How many feet? 20'

FROM	TO	PLUGGING MATERIALS

Flush mt manway was removed and 2" well casing was drilled and pulled out to TD. 16'

Bentonite from 16'-1'
Cement from
Soil from 1'-0'

7 CONTRACTOR'S OF LANDOWNER'S CERTIFICATION: This water well was plugged under my jurisdiction and was completed on (mo/day/year) 2-23-06 and this record is true to the best of my knowledge and belief. Kansas Water Well Contractor's License No. 732 This Water Well Record was completed on (mo/day/year) under the business name of QB Environmental Service by (signature) James Baker