


MW8

1 LOCATION OF WATER WELL: Fraction Section Number Township Number Range Number
 County: Wyandotte SW 1/4 SW 1/4 SW 1/4 4 11 24 EW

Distance and direction from nearest town or city street address of well if located within city?
Shell Gas Station 7740 State Ave, Kansas City, KS.

2 WATER WELL OWNER: Shell Oil Products
 RR #, St. Address, Box #: 308 Wilcox #101
 City, State, ZIP Code : Castle Rock, CO. 80104
 Board of Agriculture, Division of Water Resources
 Application Number:

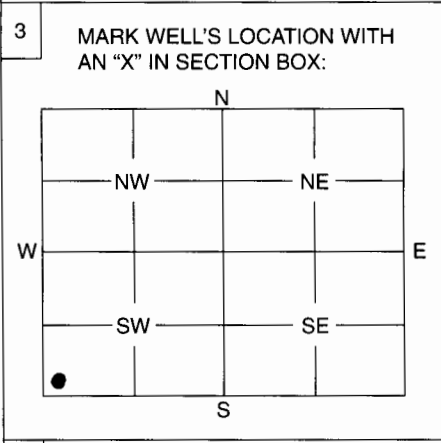

4 DEPTH OF WELL 19' ft.
 WELL'S STATIC WATER LEVEL 14.58 ft.
 WELL WAS USED AS:
 1 Domestic 5 Public Water Supply 9 Dewatering
 2 Irrigation 6 Oil Field Water Supply 10 Monitoring Well
 3 Feedlot 7 Domestic (Lawn & Garden) 11 Injection Well
 4 Industrial 8 Air Conditioning 12 Other

Was a chemical / bacteriological sample submitted to Department? Yes No X.....
 If yes, mo/day/yr sample was submitted

Water Well Disinfected: Yes No X.....

5 TYPE OF BLANK CASING USED:
 1 Steel 3 RMP (SR) 5 Wrought 7 Fiberglass 9 Other (Specify below)
2 PVC 4 ABS 6 Asbestos-Cement 8 Concrete Tile
 Blank casing diameter 2.0 in. Was casing pulled? Yes X No If yes, how much 19'
 Casing height above or below land surface N/A in.

6 GROUT PLUG MATERIAL: 1 Neat cement 2 Cement grout 3 Bentonite 4 Other Cement
 Grout Plug Intervals: From 19' ft. to 1' ft., From 1' ft. to 0 ft., From to ft.
 What is the nearest source of possible contamination:
 1 Septic tank 6 Seepage pit 11 Fuel storage 16 Other (specify below)
 2 Sewer lines 7 Pit privy 12 Fertilizer storage
 3 Watertight sewer lines 8 Sewage lagoon 13 Insecticide storage
 4 Lateral lines 9 Feedyard 14 Abandoned water well
 5 Cess pool 10 Livestock pens 15 Oil well/Gas well
 Direction from well? South How many feet? 60'

FROM	TO	PLUGGING MATERIALS

Flush mt manway was removed and 2" well casing was drilled and pulled out to TD. 19'
Bentonite from 19'-1'
Cement from 1'-0'
Soil from

7 CONTRACTOR'S OF LANDOWNER'S CERTIFICATION: This water well was plugged under my jurisdiction and was completed on (mo/day/year) 2-23-06 and this record is true to the best of my knowledge and belief. Kansas Water Well Contractor's License No. 732
 This Water Well Record was completed on (mo/day/year) under the business name of QB Environmental Services
 by (signature) James Bieker