


1 LOCATION OF WATER WELL: County: **Wyandotte** Fraction: **SE 1/4 NW 1/4 SE 1/4** Section Number: **30** Township Number: **T 11 S** Range Number: **R 24 E/W**

Distance and direction from nearest town or city street address of well if located within city?
2140 S. 88th Street, Kansas City

2 WATER WELL OWNER: **Fuchs Lubricants Company**
 RR#, St. Address, Box #: **2140 S. 88th Street**
 City, State, ZIP Code: **Kansas City, KS 66111-1756**
 Board of Agriculture, Division of Water Resources
 Application Number:

3 LOCATE WELL'S LOCATION WITH AN "X" IN SECTION BOX:

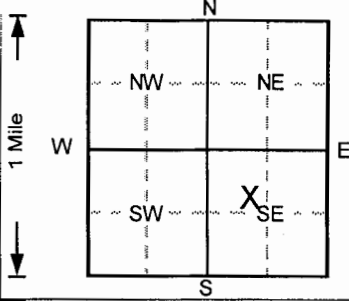

4 DEPTH OF COMPLETED WELL: **40** ft. ELEVATION: _____
 Depth(s) Groundwater Encountered 1. _____ ft. 2. _____ ft. 3. _____ ft.
 WELL'S STATIC WATER LEVEL: **32.5** ft. below land surface measured on mo/day/yr **6/22/2006**
 Pump test data: Well water was **NA** ft. after _____ hours pumping _____ gpm
 Est. Yield: **NA** gpm: Well water was _____ ft. after _____ hours pumping _____ gpm
 Bore Hole Diameter: **6** in. to **40** ft., and _____ in. to _____ ft.
 WELL WATER TO BE USED AS:
 5 Public water supply 8 Air conditioning 11 Injection well
 1 Domestic 3 Feedlot 6 Oil field water supply 9 Dewatering 12 Other (Specify below)
 2 Irrigation 4 Industrial 7 Lawn and garden only **10 Monitoring well**
 Was a chemical/bacteriological sample submitted to Department? Yes _____ No ; If yes, mo/day/yr sample was submitted _____
 Water Well Disinfected? Yes _____ No

5 TYPE OF BLANK CASING USED:
 1 Steel 3 RMP (SR) 5 Wrought iron 8 Concrete tile CASING JOINTS: Glued _____ Clamped _____
2 PVC 4 ABS 6 Asbestos-Cement 9 Other (specify below) Welded _____
 7 Fiberglass Threaded

Blank casing diameter: **2** in. to **19.6** ft., Dia **39.6** in. to **40** ft., Dia _____ in. to _____ ft.
 Casing height above land surface: **0** in., weight _____ lbs./ft. Wall thickness or gauge No. **Sch. 40**

TYPE OF SCREEN OR PERFORATION MATERIAL
 1 Steel 3 Stainless steel 5 Fiberglass **7 PVC** 10 Asbestos-cement
 2 Brass 4 Galvanized steel 6 Concrete tile 9 ABS 11 Other (specify) _____
 12 None used (open hole)

SCREEN OR PERFORATION OPENINGS ARE:
 1 Continuous slot **3 Mill slot** 5 Gauzed wrapped 8 Saw cut 11 None (open hole)
 2 Louvered shutter 4 Key punched 6 Wire wrapped 9 Drilled holes
 7 Torch cut 10 Other (specify) _____

SCREEN-PERFORATED INTERVALS: From **19.6** ft. to **39.6** ft., From _____ ft. to _____ ft.
 From _____ ft. to _____ ft., From _____ ft. to _____ ft.
 GRAVEL PACK INTERVALS: From **17** ft. to **40** ft., From _____ ft. to _____ ft.
 From _____ ft. to _____ ft., From _____ ft. to _____ ft.

6 GROUT MATERIAL: 1 Neat cement 2 Cement grout **3 Bentonite** **4 Other Concrete**
 Grout Intervals: From **0** ft. to **1** ft., From **1** ft. to **17** ft., From _____ ft. to _____ ft.

What is the nearest source of possible contamination:
 1 Septic tank 4 Lateral lines 7 Pit privy 10 Livestock pens 14 Abandoned water well
 2 Sewer lines 5 Cess pool 8 Sewage lagoon 11 Fuel storage 15 Oil well/Gas well
 3 Watertight sewer lines 6 Seepage pit 9 Feedyard 12 Fertilizer storage 16 Other (specify below)
 13 Insecticide storage
 Direction from well? _____ How many feet? _____

FROM	TO	LITHOLOGIC LOG	FROM	TO	PLUGGING INTERVALS
0	2	Clay, some silt, dry, nonplastic, Lt. Brown			
2	6	Clay, tr. silts, loose, sl. plas., Black			
6	14	Silt, tr. vf sand, loose, damp, Lt. Brownish Gr			
14	18	Silt, tr. f sand, loose, damp, tr. clay, Lt. Brown			
18	22.5	Sand (f), silt, damp, loose, Lt. Brown to Gray			
22.5	29	Sand (f), silty, well graded, loose, Gray			
29	30.5	Clay, tr. silt, soft, plastic, damp, Black			
30.5	34	Sand (f), damp, loose, Gray			
34	36	Silt, sandy, loose, wet, Black			
36	38	Clay, med. consistency, highly plastic, Dk. Gra			
38	40	Sand (f-c), poorly graded, some gravels, Gray			
					MW13, Flushmount
					Project Name: BM - Ks City, Fuchs Lubricants
					GeoCore # 1306, #

7 CONTRACTOR'S OR LANDOWNER'S CERTIFICATION: This water well was **1** constructed, (2) reconstructed, or (3) plugged under my jurisdiction and was completed on (mo/day/year) **6/21/2006** and this record is true to the best of my knowledge and belief.
 Kansas Water Well Contractor's License No. **527** This Water Well Record was completed on (mo/day/yr) **7/10/2006**
 under the business name of **GeoCore, Inc.** by (signature) *Sal Kohl*